


T.5S. R.5W.W.M.

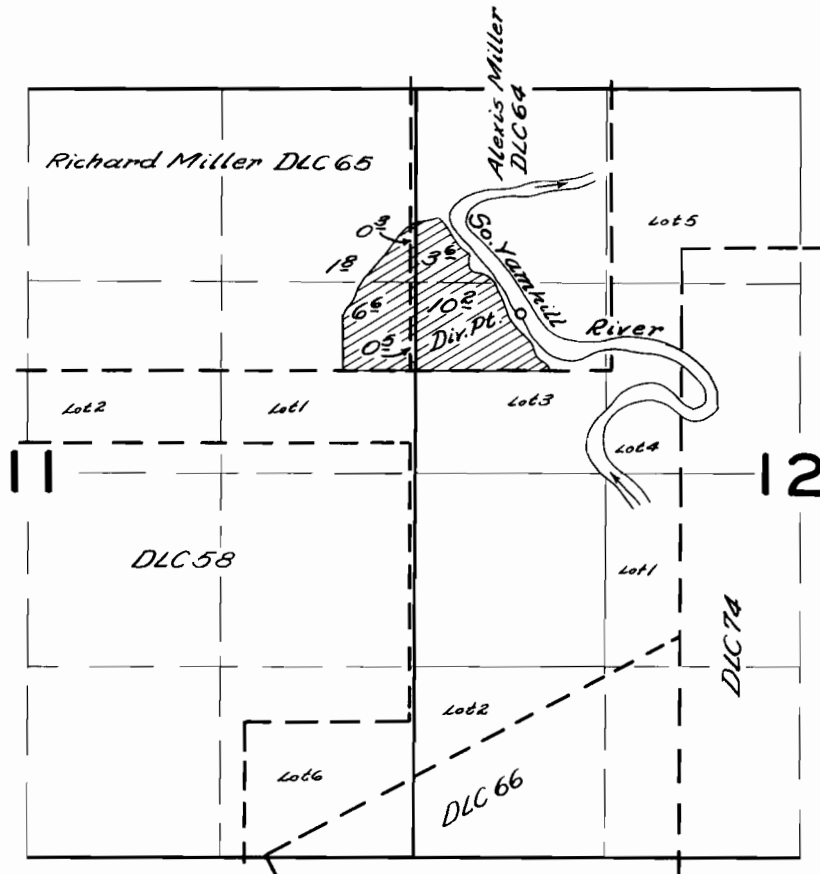

FINAL PROOF SURVEY
UNDER

Application No. 28275. Permit No. 22231.
IN NAME OF

Oscar Wideman

Surveyed *June 3, 1958*, by *M. Bisk*