


# T.I.S.R.I.E.W.M.

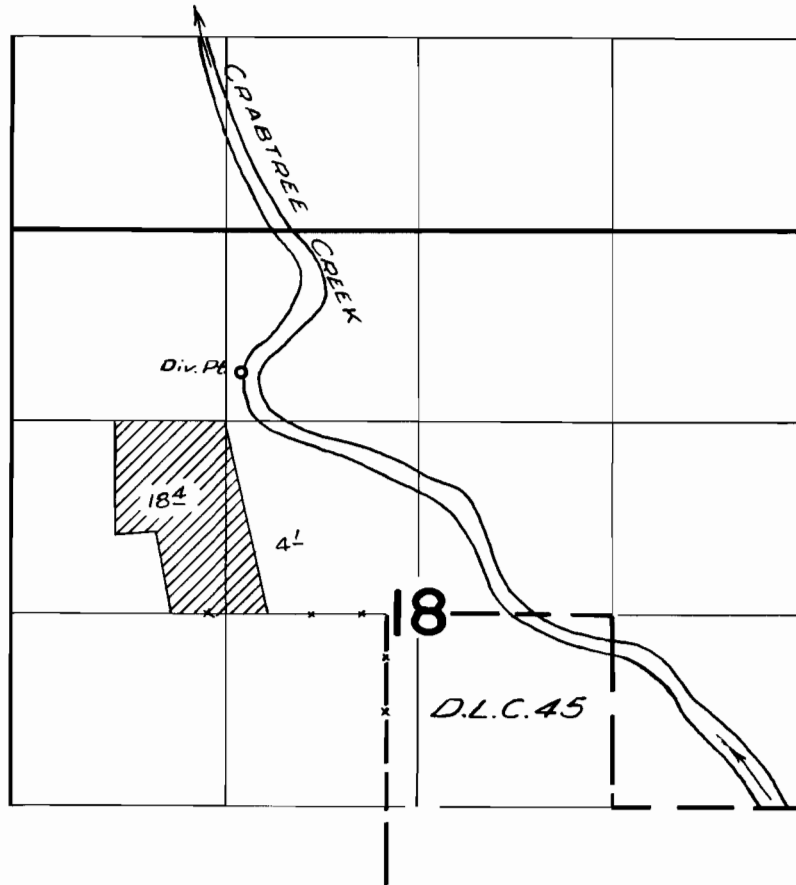

## FINAL PROOF SURVEY UNDER

Application No. 30014 Permit No. 23634  
IN NAME OF

JAMES & LOIS KINGSBURY

Surveyed 6 JUNE 1961, by M. B. [Signature]