


T.11S., R.5W., W.M.

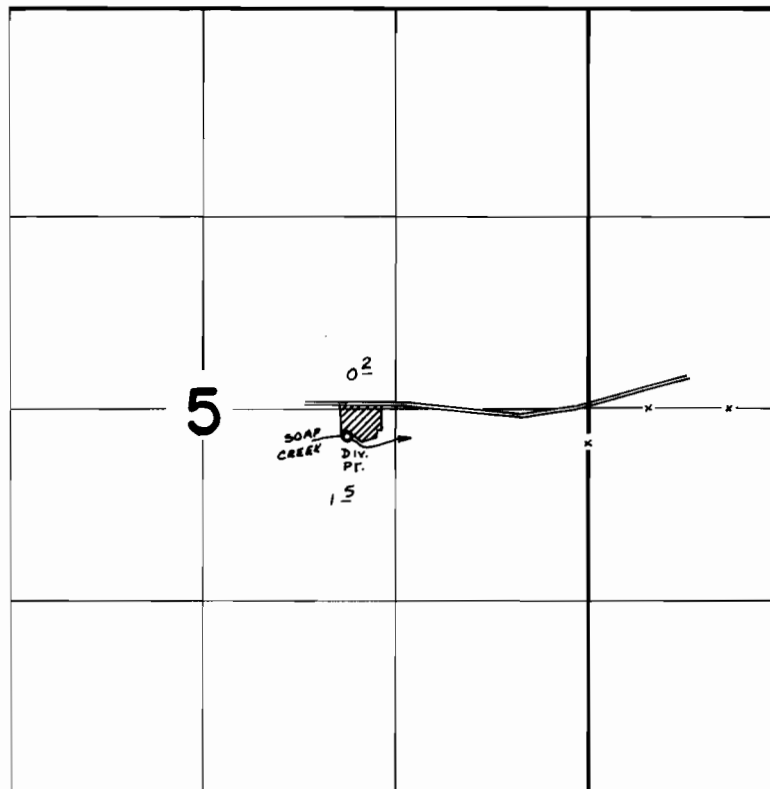

DIV. PT. LOCATED: 180' S & 1650' W FROM E $\frac{1}{4}$ SEC 5

FINAL PROOF SURVEY
UNDER

Application No. 47476 Permit No. 35070
IN NAME OF

CHARLES L. WILCOX

Surveyed Aug 18 1972, by D. Norby