


SEE MAP 25 C

NW 1/4 NW 1/4 SEC 36 T 27 S R 13 W

36 BB

1 INCH = 100'

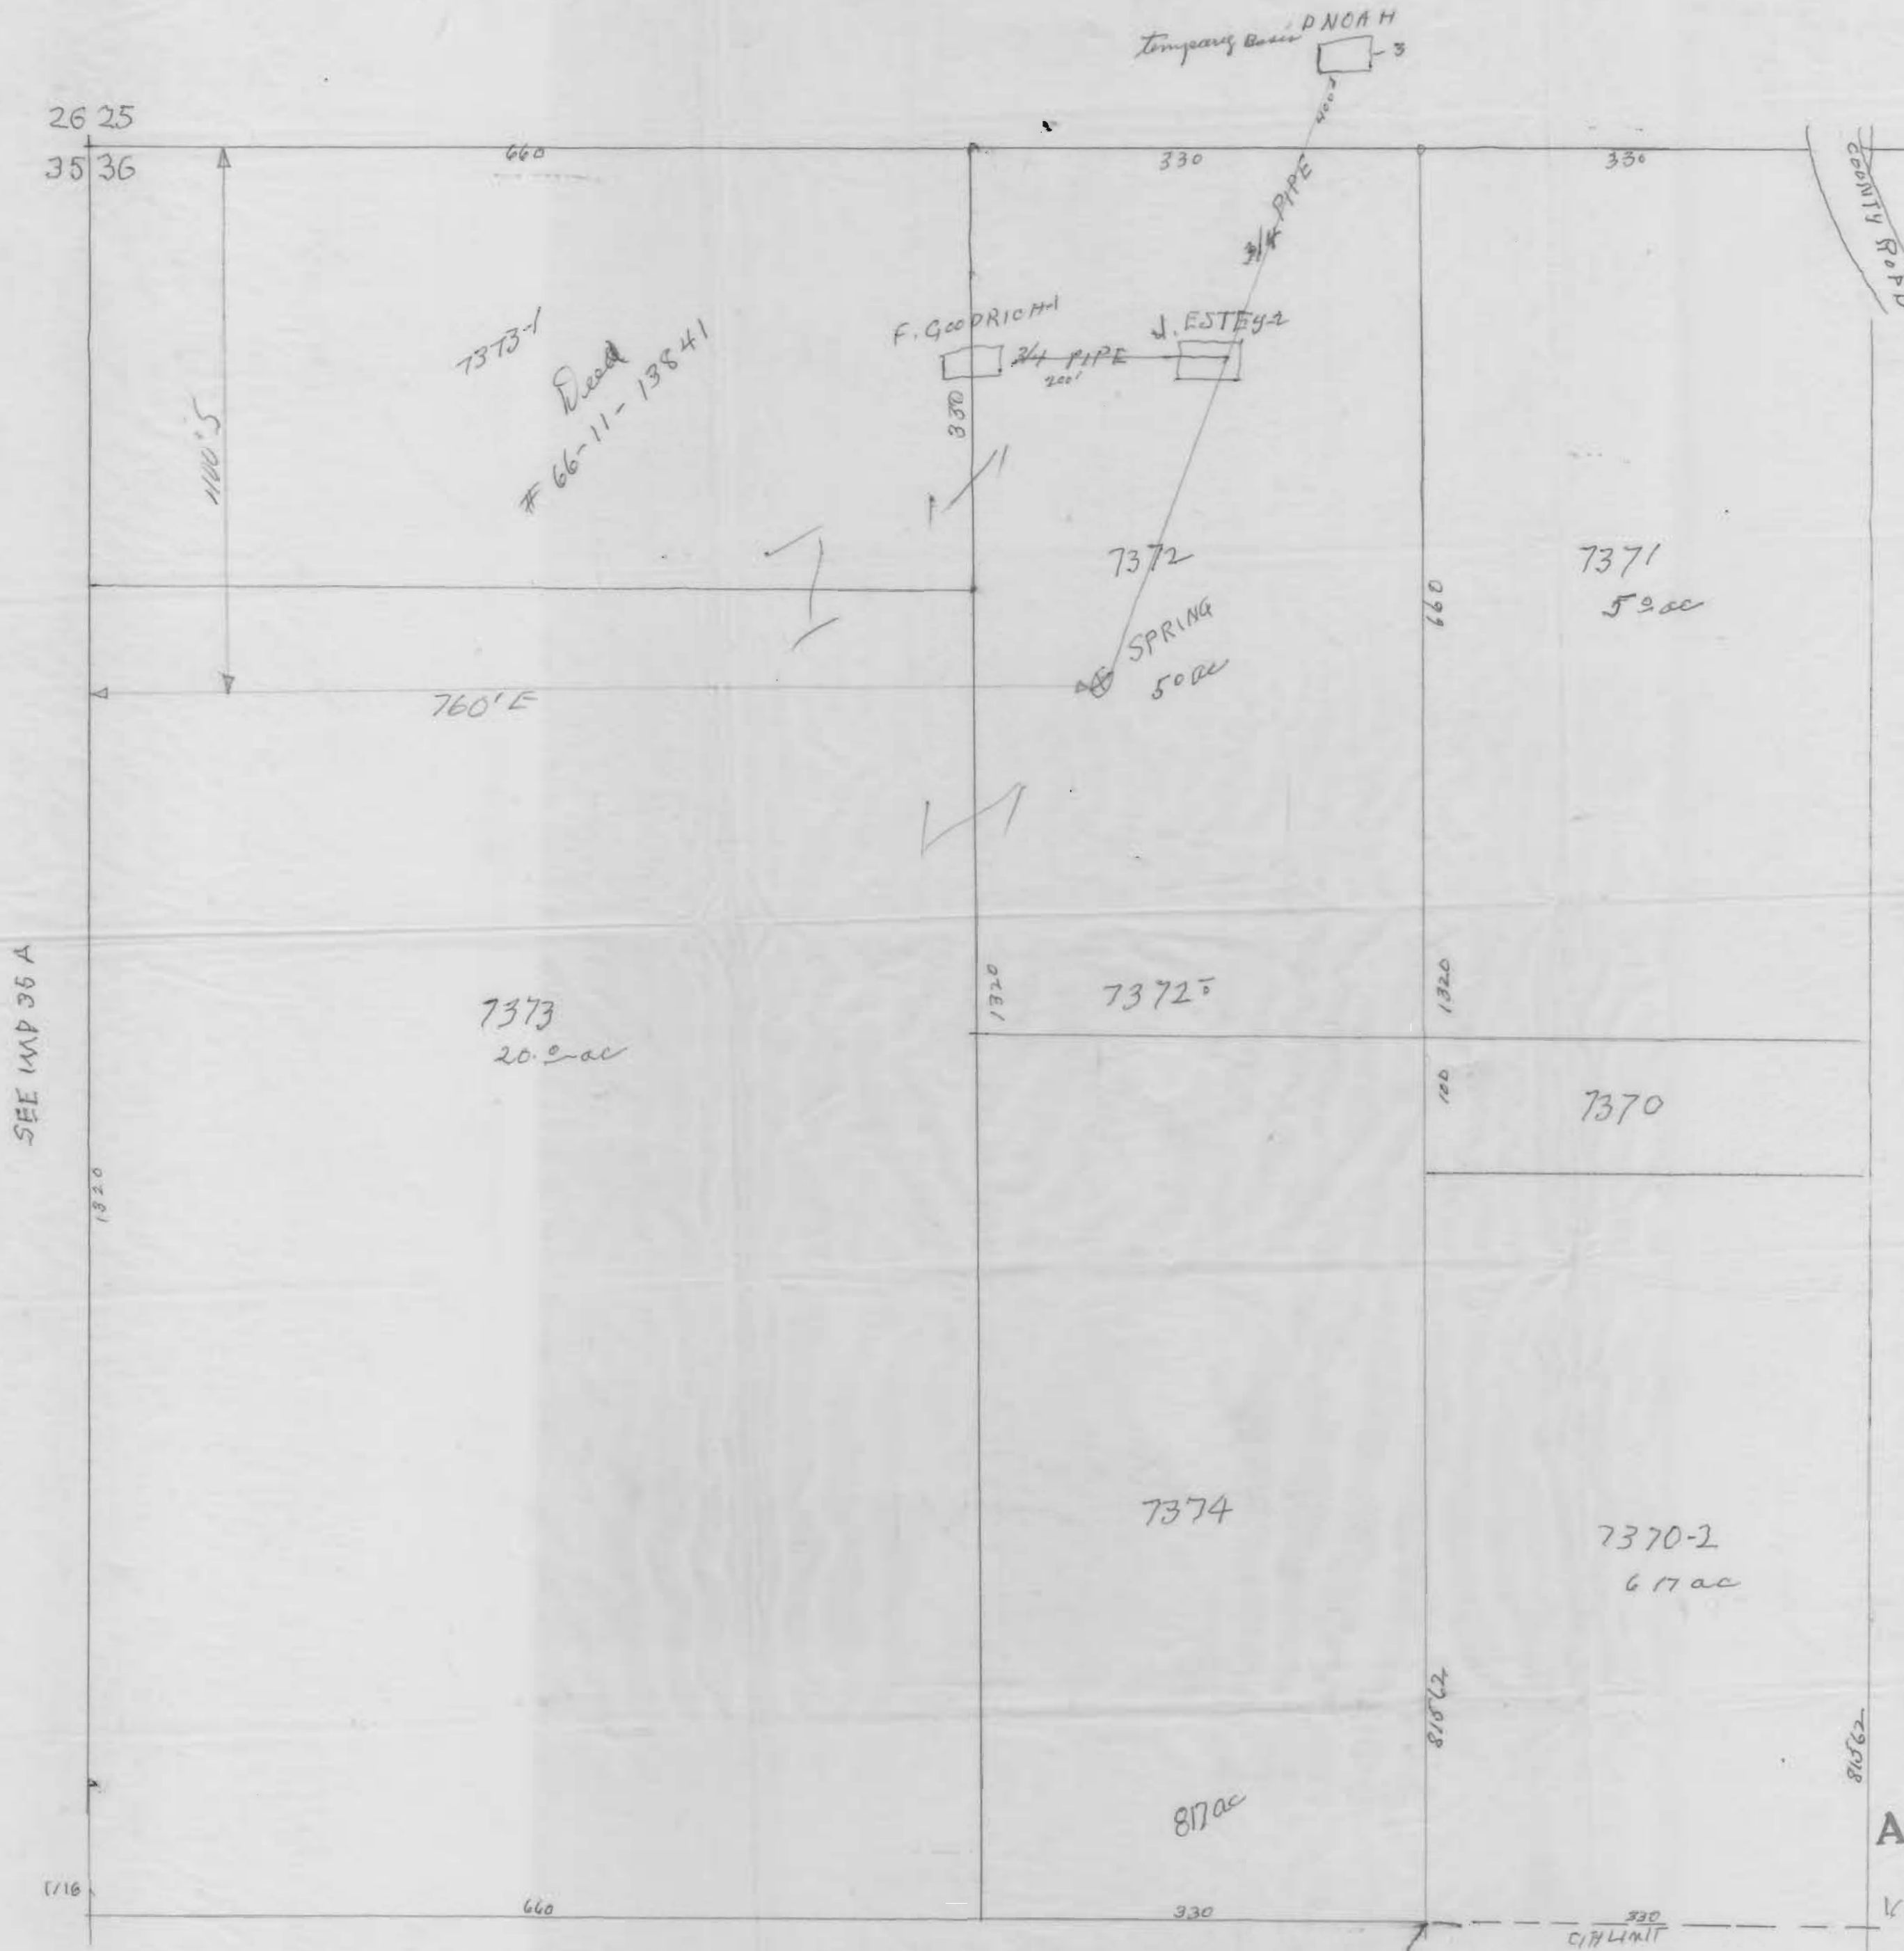

SEE MAP 36 A

SEE MAP 36 BA

RECEIVED
FEB 22 1971
STATE ENGINEER
SALEM, OREGON

RECEIVED
JAN 8 1971
STATE ENGINEER
SALEM, OREGON

Application No. 47743
Permit No. 35761

SEE MAP 36 BC

COQUILLE 36 BB