


T.26S.R.5W.W.M.

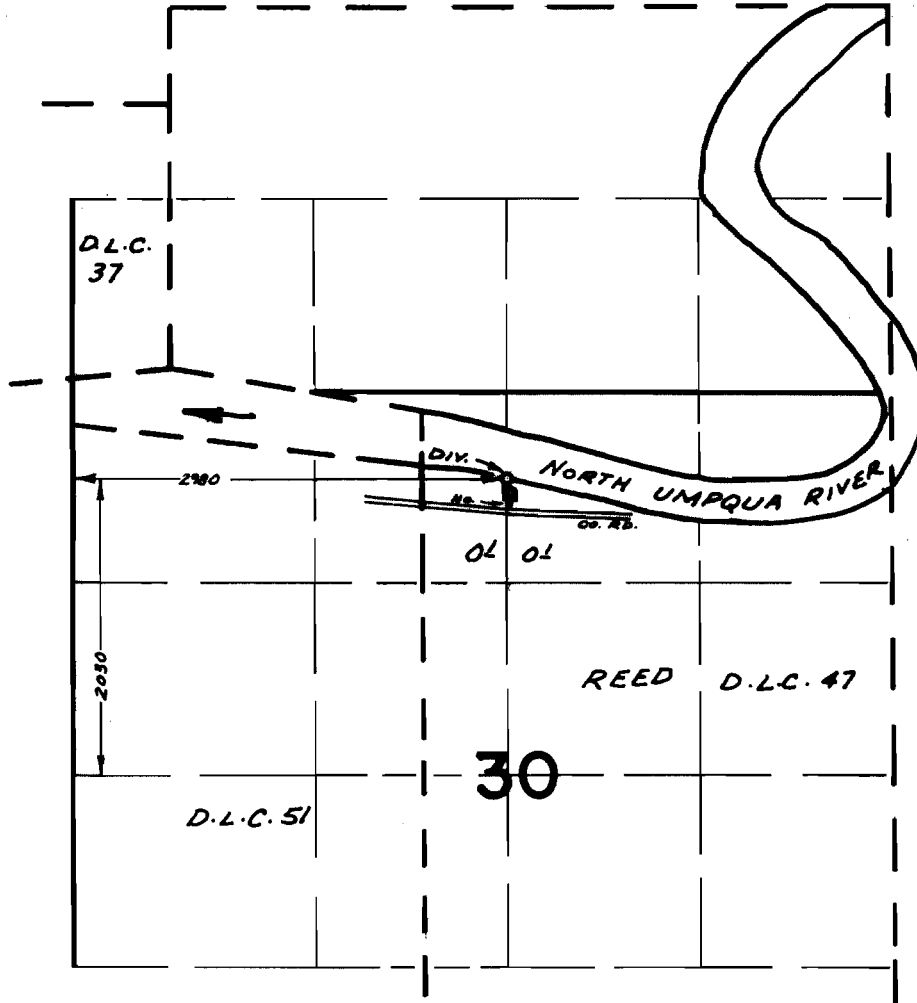

FINAL PROOF SURVEY UNDER

Application No. 41891 Permit No. 31335
IN NAME OF

..... BEN DIRKSEN

Surveyed MAY 2, 1972, by R. MUGKEN