


T. 9 S. R. 26 E. W. M.

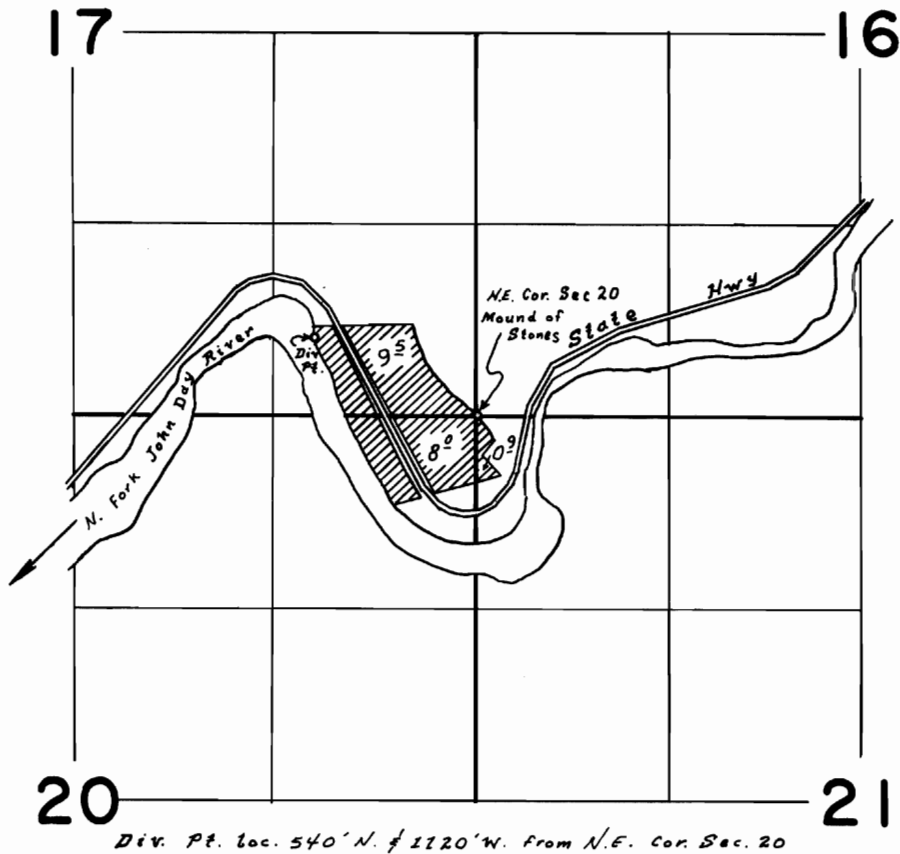

FINAL PROOF SURVEY
UNDER

Application No. 47349 Permit No. 35469
IN NAME OF

CYRUS L. GOODWIN

Surveyed 1 Aug. 1972, by L.E. Gould