


7
R-4958
32359

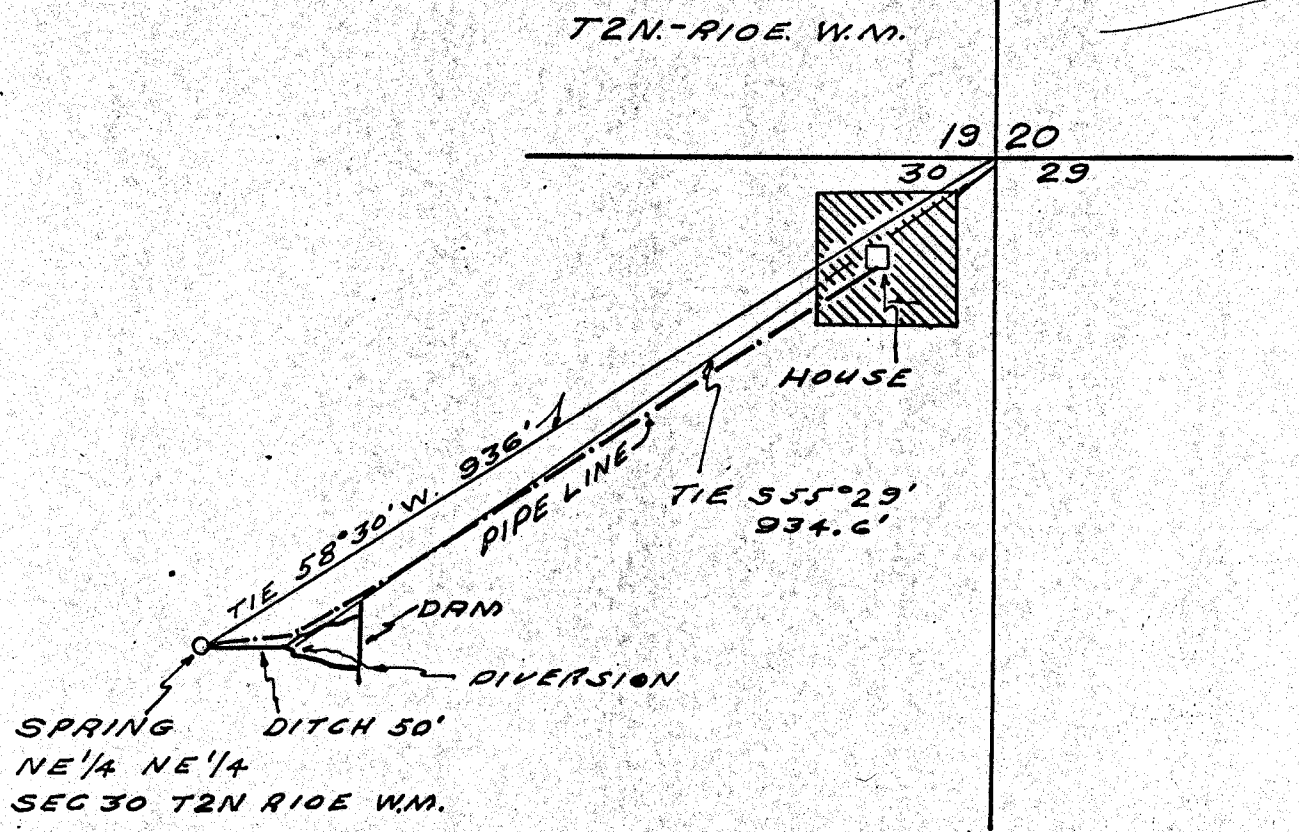

SCALE 1" = 200'

ARTHUR B. CEARLEY
RT. 3, Box 654
HOOD RIVER, ORE. 97031

RECEIVED
S. J. ...
...
...

RECEIVED
...
CIVIL ENGINEER
... OREGON

Application No. 43322
& R-43323
~~#35024~~
R-4958