

G-3102


40426

Pg 1 of 2

Application No. G-3506
Permit No. G-3102

WELL IN SE $\frac{1}{4}$ NW $\frac{1}{4}$ SW $\frac{1}{4}$ SE $\frac{1}{4}$ SEC 17
T41S R13E WM KLAMATH CO. OREGON
690 FT NORTH & 375 FT EAST OF
THE SW CORNER OF SE $\frac{1}{4}$ SEC. 17

Best River wells

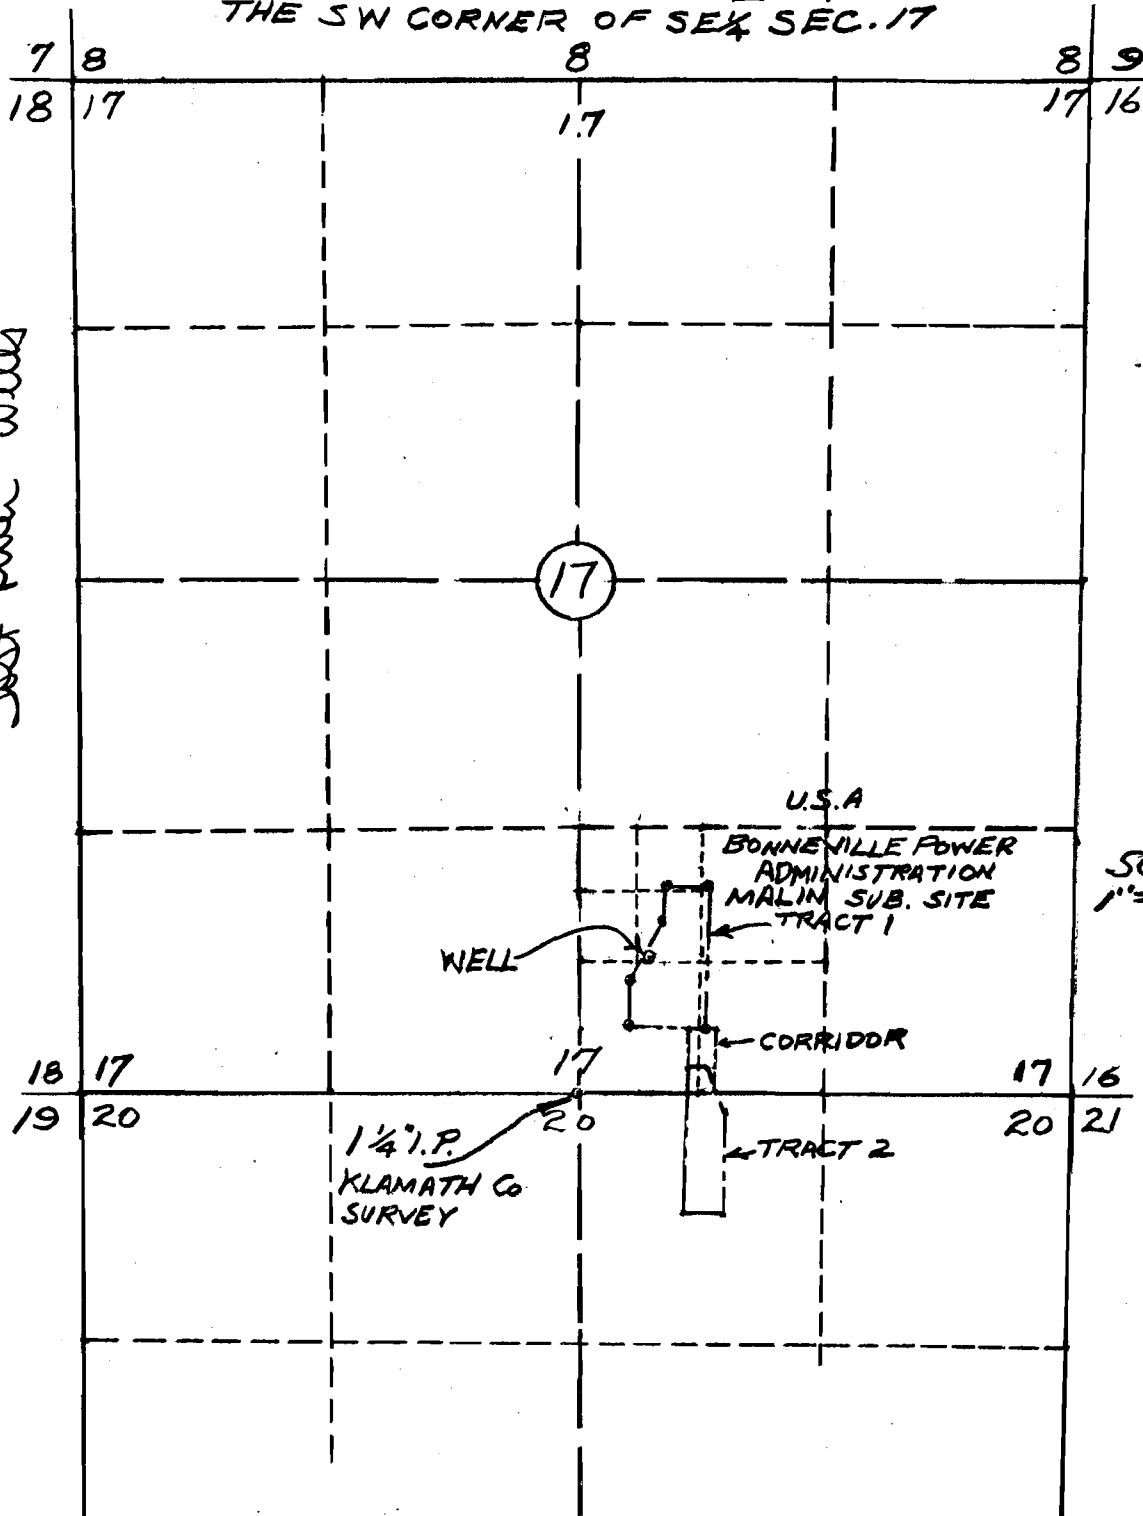

G-3102

2 of 2

U.S. DEPARTMENT OF THE Interior,
Bonneville Power Adm.
A # G-3506, P # G-3102

