


G-4448

40427

T.38S., R.11E., W.M.

Bucke Creek & Yonna Valley wells

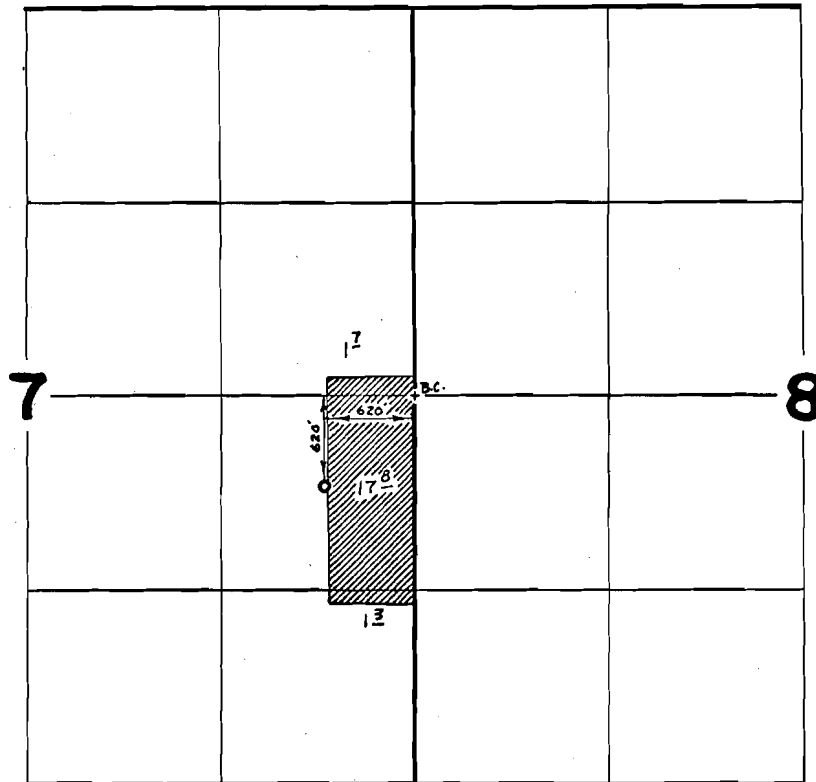

FINAL PROOF SURVEY
UNDER

Application No. G-4728 Permit No. G-4448
IN NAME OF

WEYERHAEUSER COMPANY

Surveyed Oct 13 1972, by D. Norby