


R-5782
40429

T.40S., R.11E., W.M.

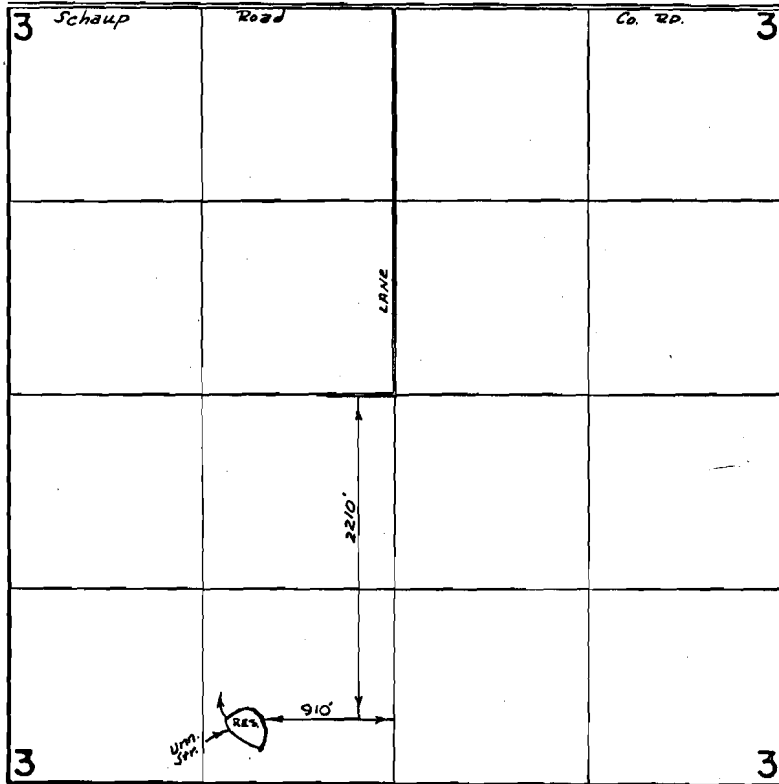


FINAL PROOF SURVEY
UNDER

Application No. R-47792 Permit No. R-5782
IN NAME OF

J.F. RODGERS

Surveyed Oct 17 1972, by D. Norby