


T. 41 S. R. 25 E. W.M.

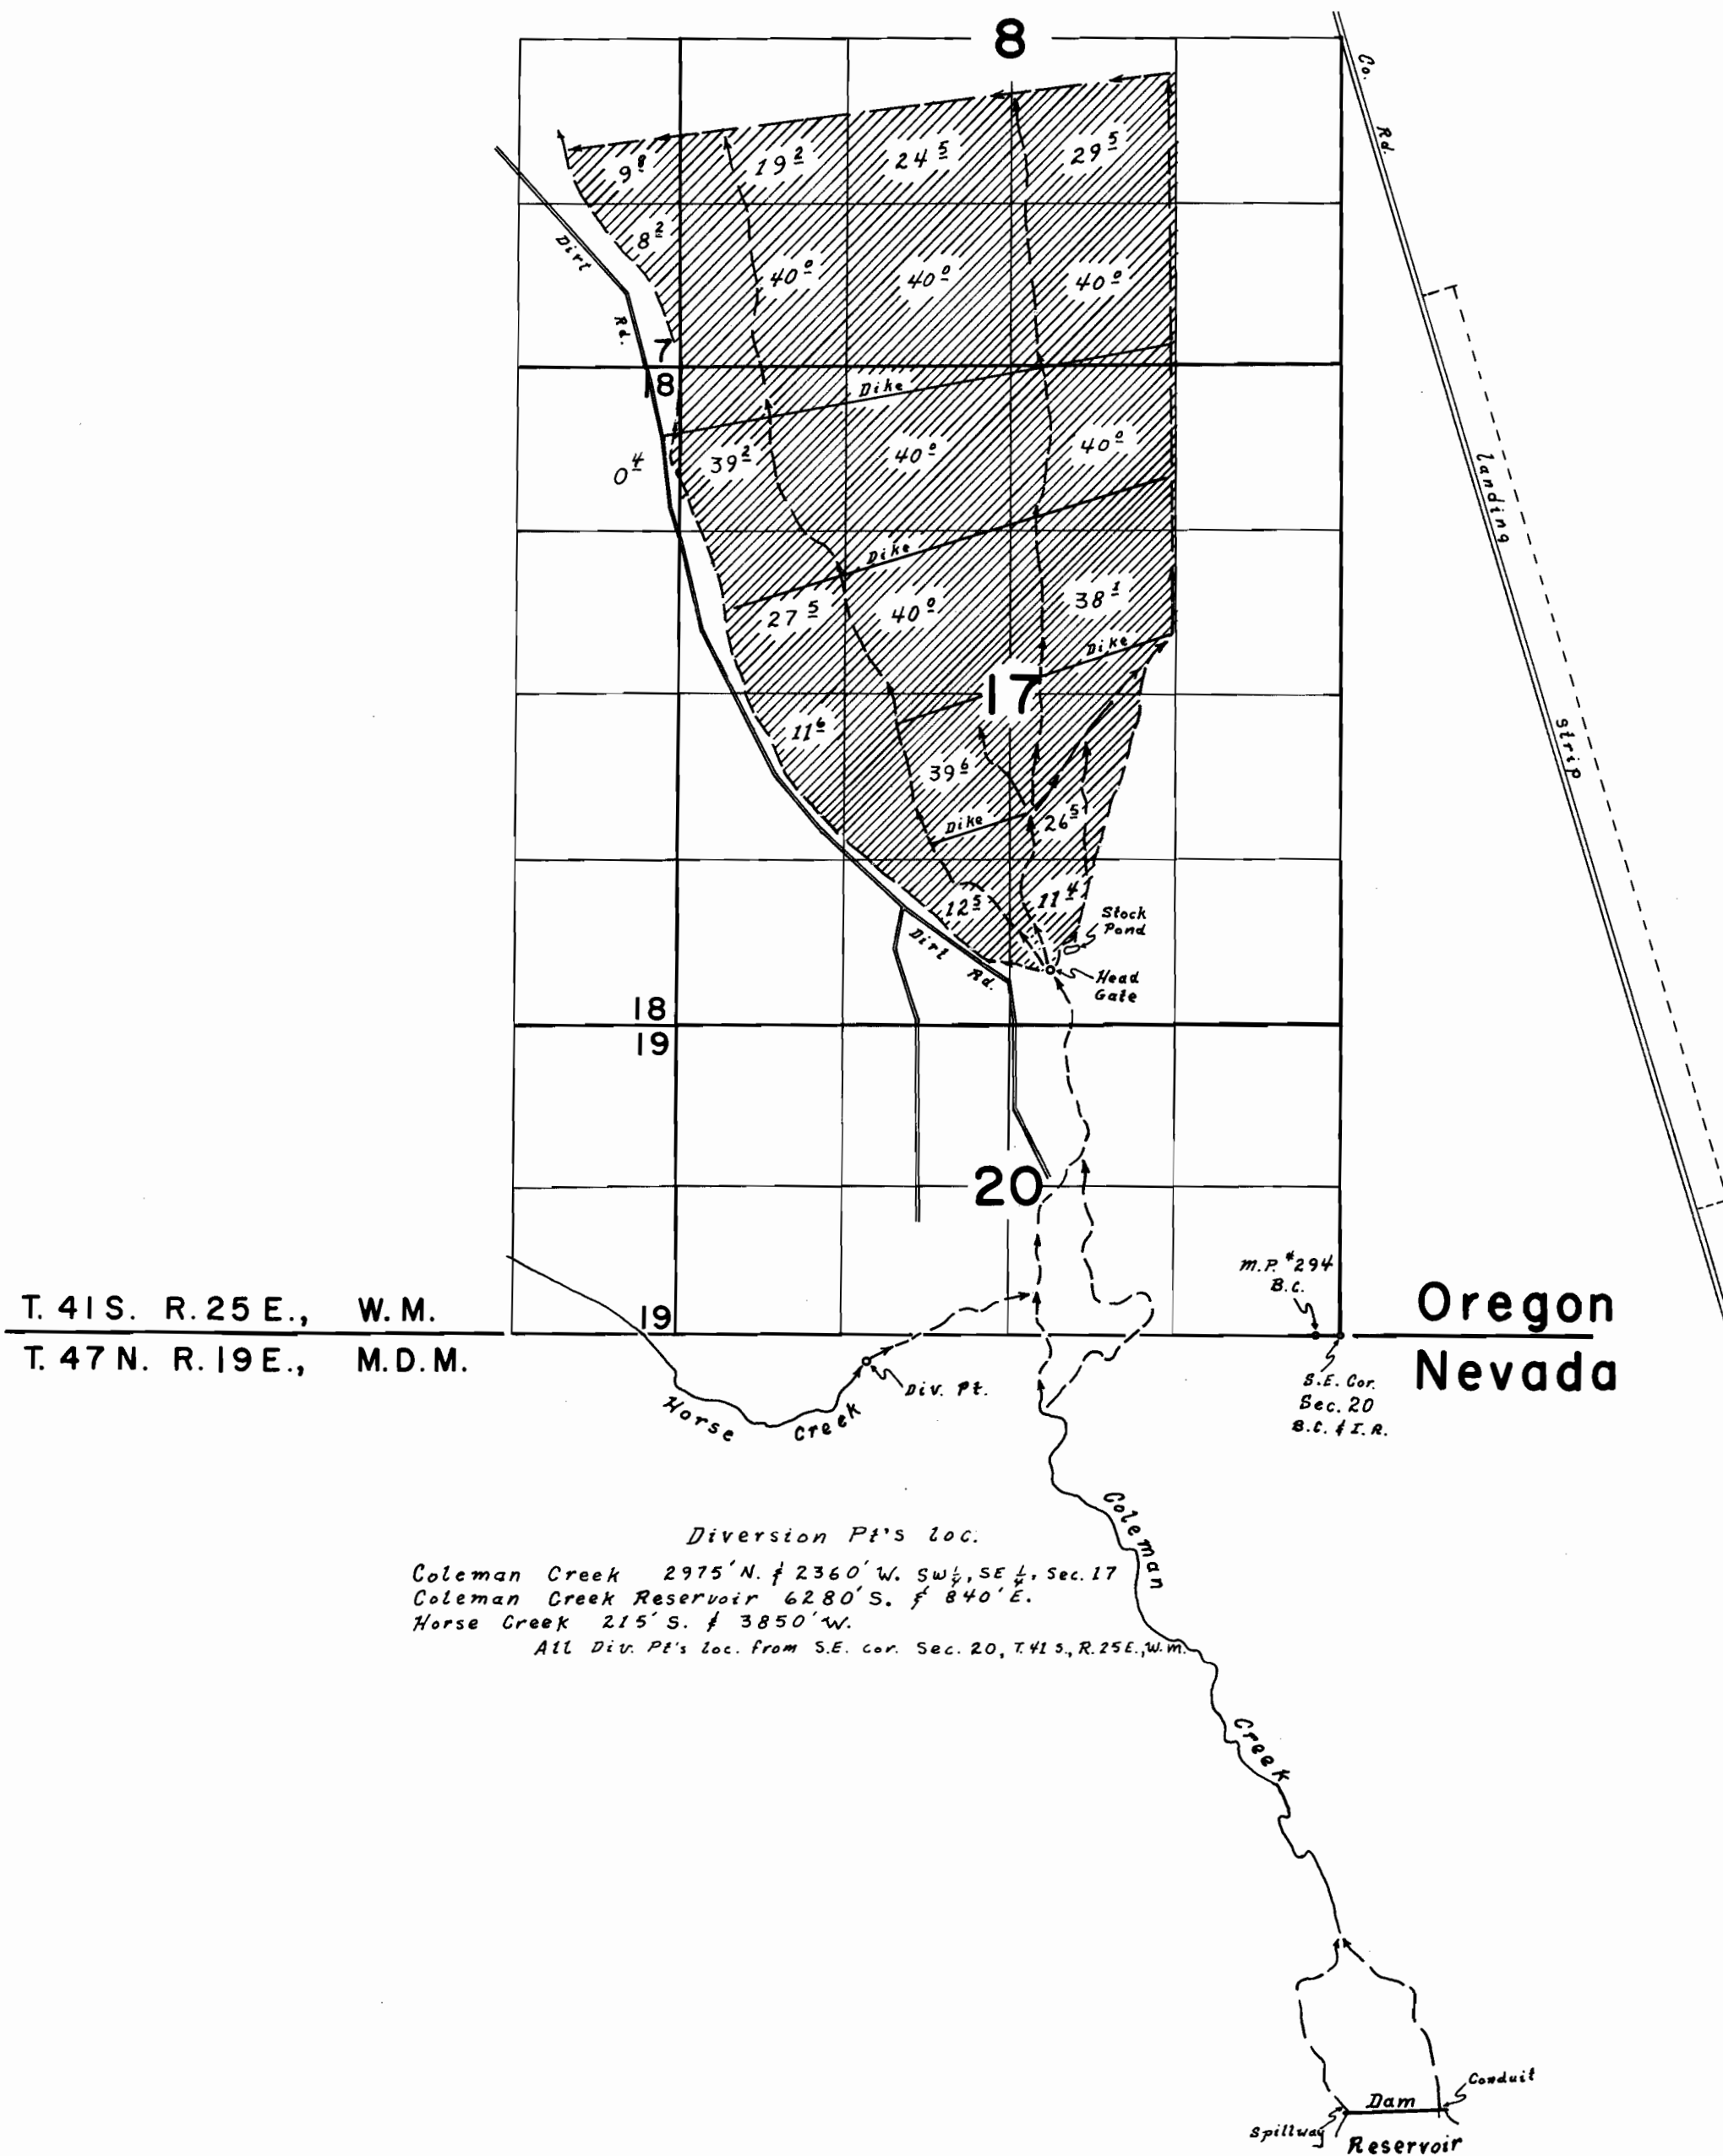

**FINAL PROOF SURVEY
UNDER**

42380 31660

Application No. 42379 Permit No. 31659
IN NAME OF

Donovan L. Nicol

Surveyed 12 Sept. 1972 by L.E. Gould