


T.6S. R.I.E. W.M.

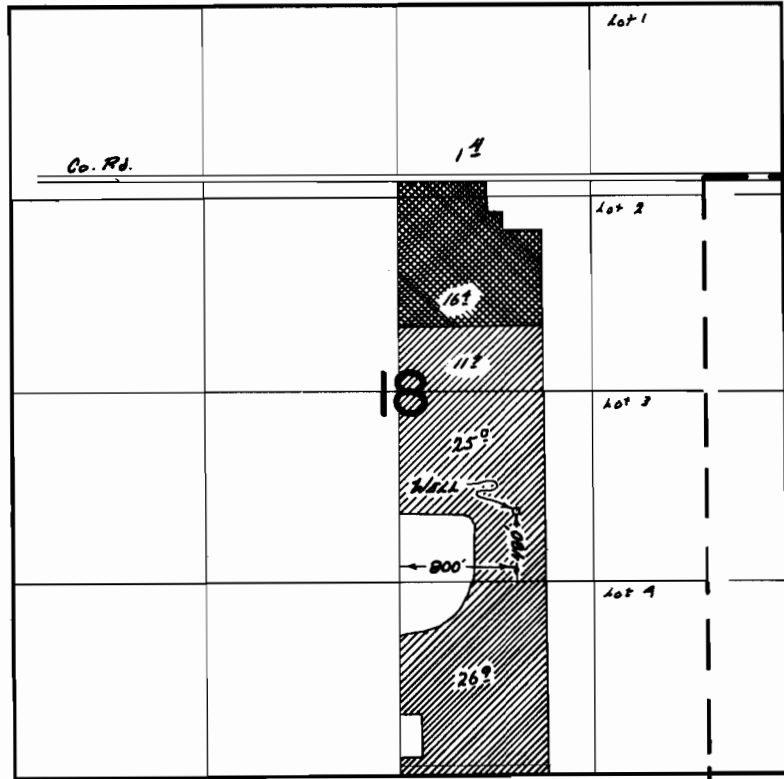

 PRIMARY
 SUPPLEMENTAL

FINAL PROOF SURVEY UNDER

Application No. 6-3173 Permit No. 6-2984
IN NAME OF

L. E. WOODLEY

Surveyed JUNE 7 1973, by R. G. MUCKEN