


T.5S. R.1W. W.M.

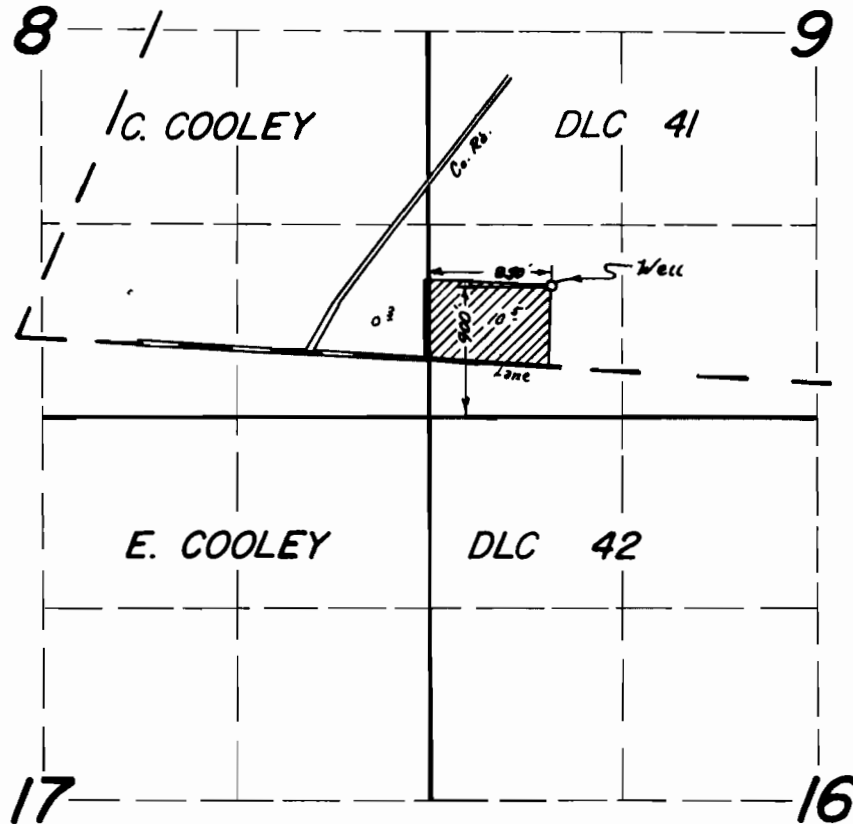

FINAL PROOF SURVEY
UNDER

Application No. 6-3885 Permit No. 6-3651
IN NAME OF

TREVOR A. STEELE

Surveyed April 24 1973, by R. B. Mucken