


T.4S. R.2W. W.M.

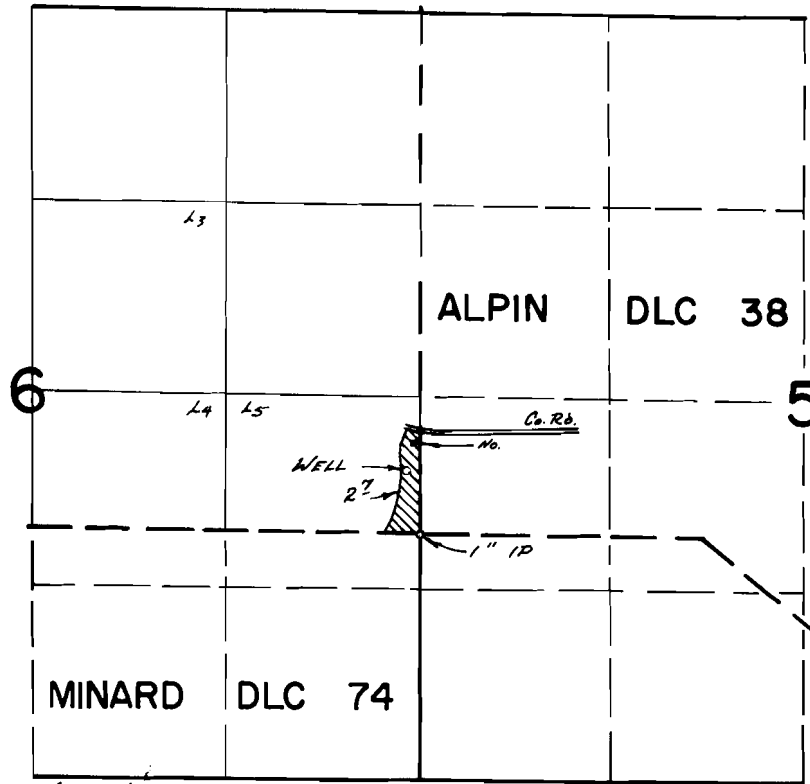

WELL LOC. 430' N & 90' W FROM SE COR Lot 5

FINAL PROOF SURVEY
UNDER

Application No. G-4250 Permit No. G-4009
IN NAME OF

MR. JOHN FREDRICKSON

Surveyed JUNE 6 1977, by R.G. MUCKEN