


# T.6S. R.2W. W.M.

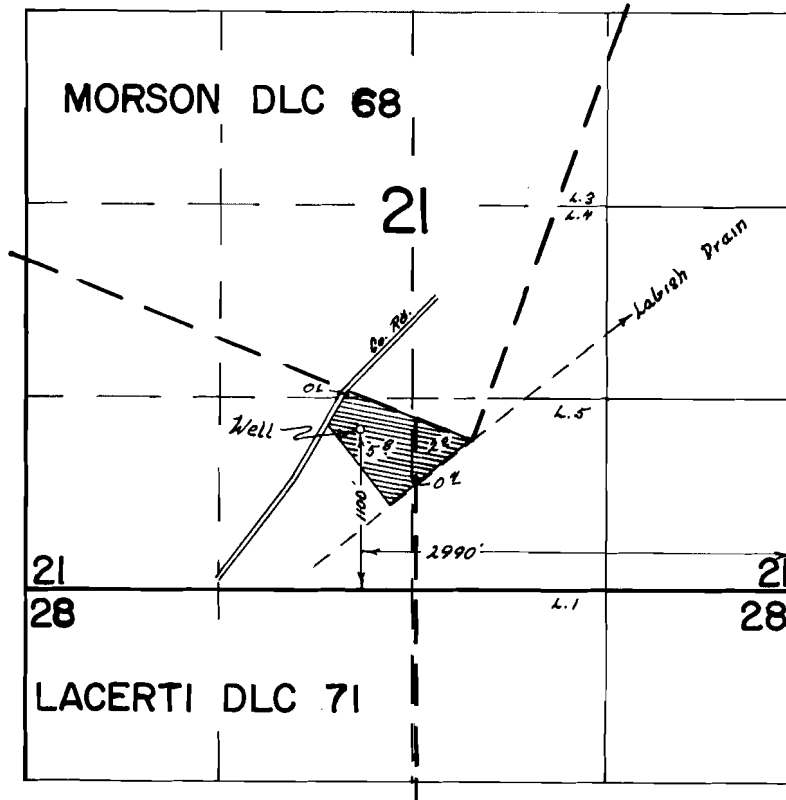

## FINAL PROOF SURVEY UNDER

Application No. B-4496 Permit No. R-4232  
IN NAME OF

A. J. HARRIS

Surveyed April 27 1972, by R. G. Mucken