


T.4S. R.2W. W.M.

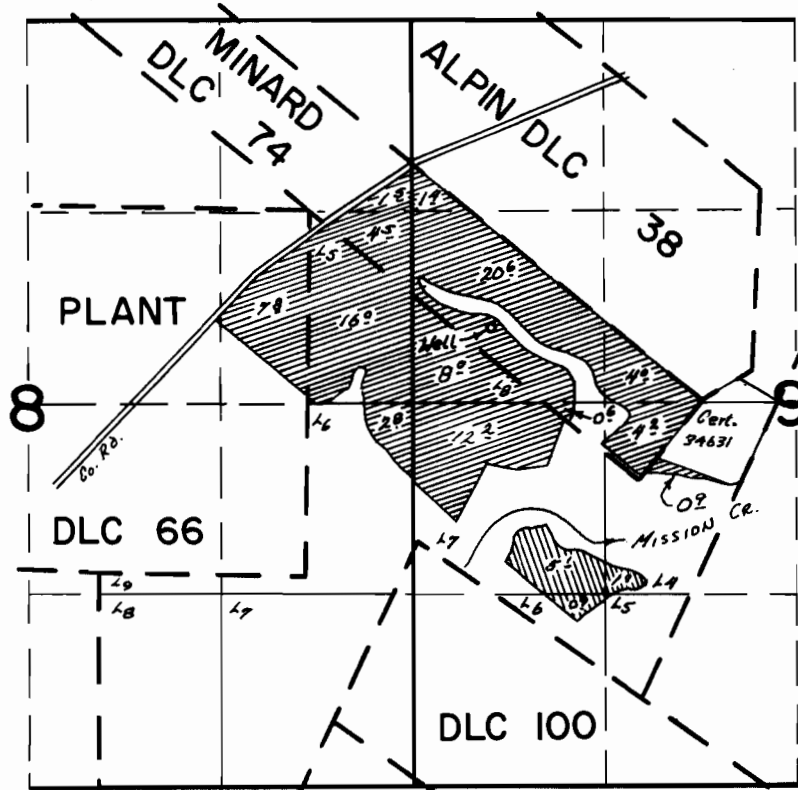

WELL Loc 500' N & 1450' N FROM MOST S1/4 COR ALPIN DLC. 38

 PRIMARY
 SUPPLEMENTAL

FINAL PROOF SURVEY UNDER

Application No. G-4623 Permit No. G-4348
IN NAME OF

PETER J., NIK, GEORGE & PETER THIERJUNG

Surveyed May 15 1979, by R. B. MUCKEN