T. 6 S. R. 2 W. W.M.

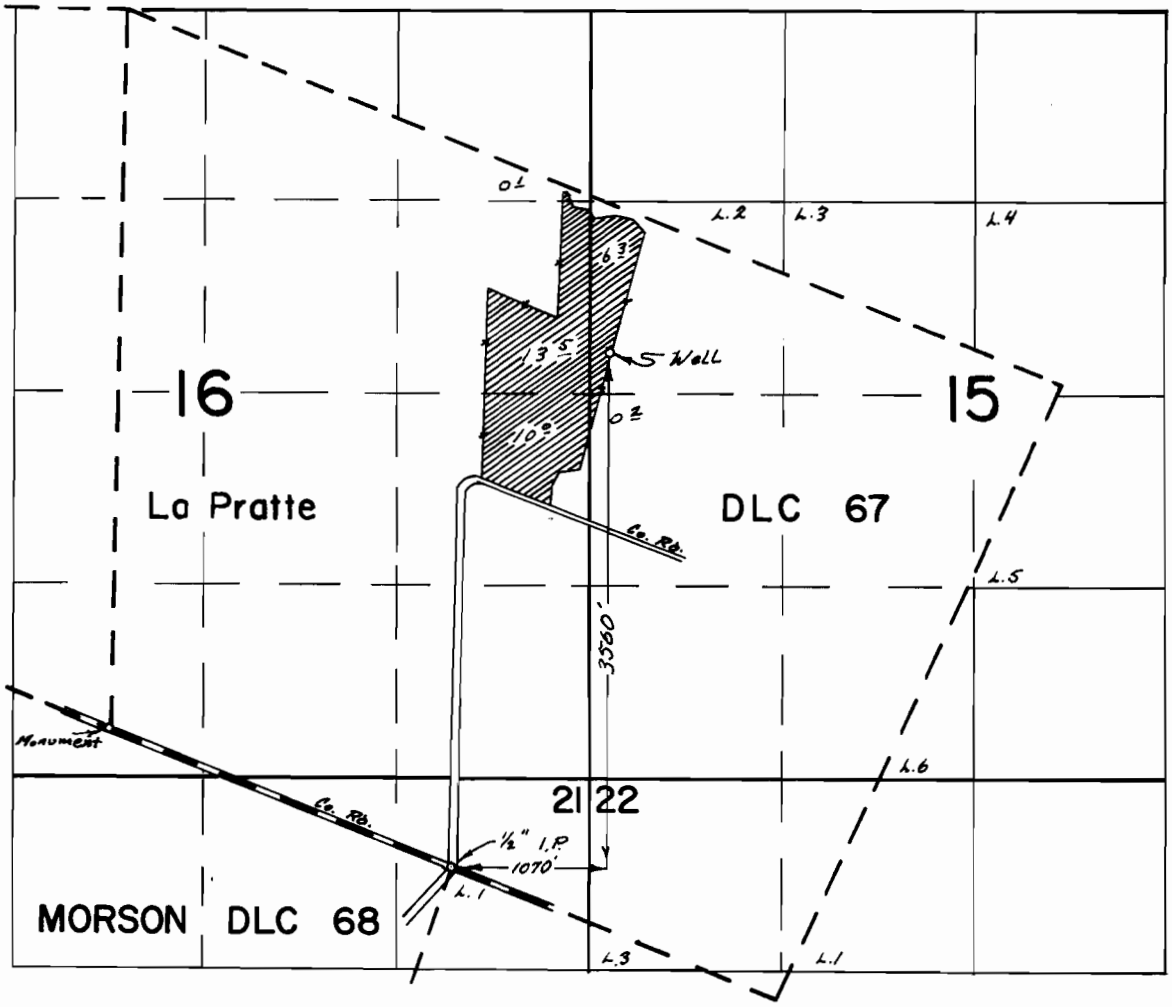

FINAL PROOF SURVEY
UNDER

Application No. G-4806 Permit No. G-4571
IN NAME OF

JOHN A. HAY

Surveyed May 17 19 72, by R. G. Mucken

TAP
PTS 1972 R