


T.9S.R.1E.W.M.

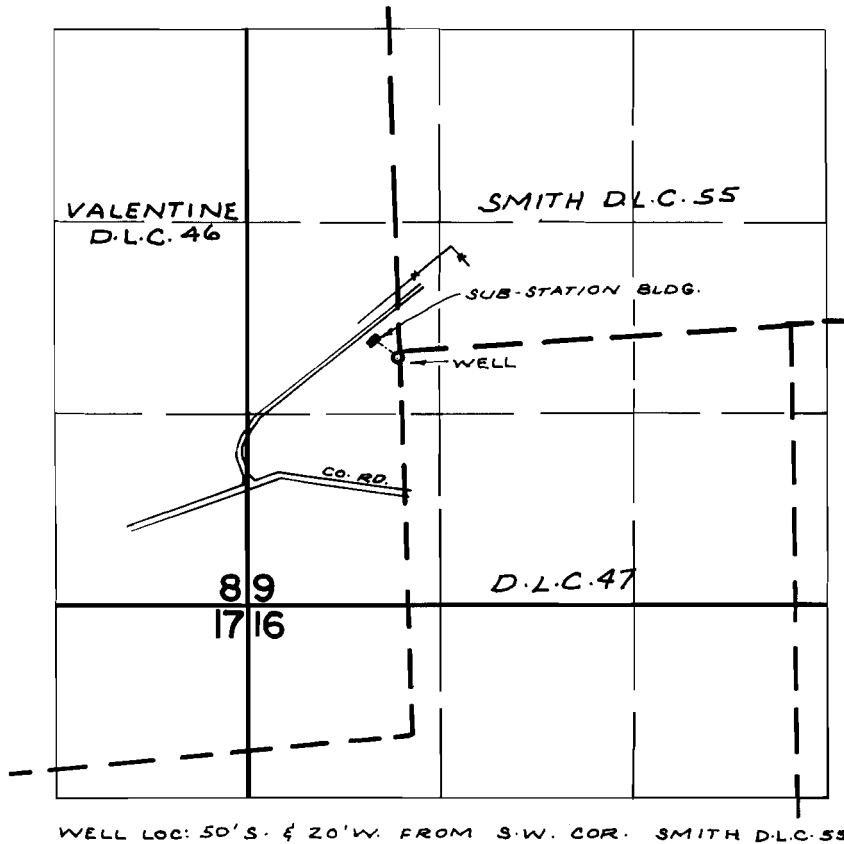

FINAL PROOF SURVEY UNDER

Application No. G-5583. Permit No. G-4945
IN NAME OF

U.S. DEPARTMENT OF THE INTERIOR

Surveyed JULY 26, 1972, by R. MUCKEN