


T.7 S. R.1 W. W.M.

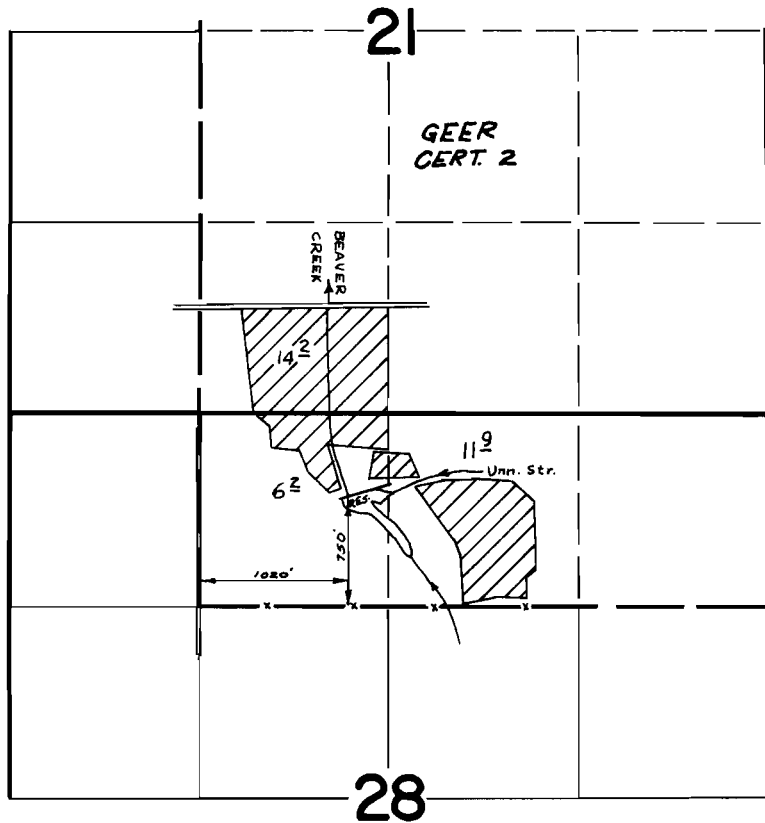

FINAL PROOF SURVEY
UNDER

Application No. R-42492 42493 Permit No. R-4719 31221
IN NAME OF

THEODORE RICHES

Surveyed Apr. 26 19 72, by D. Norby