


T. 4 S., R. 2 W., W.M.

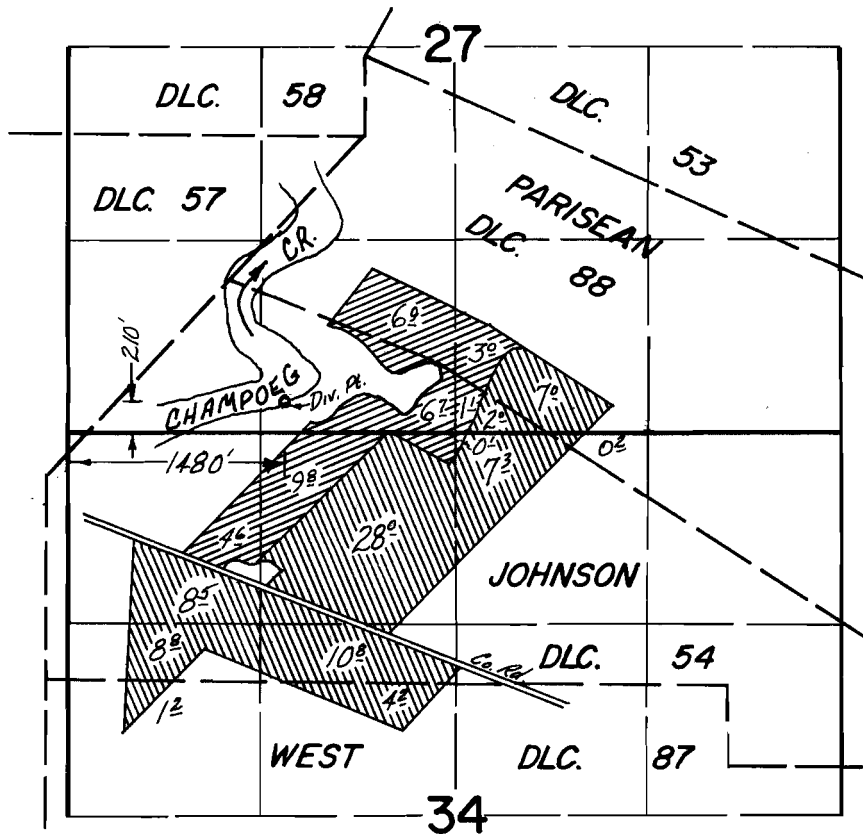

PRIMARY - [diagonal hatching]

SUPPL - [cross-hatching]

FINAL PROOF SURVEY
UNDER

Application No. 44513 Permit No. 32873
IN NAME OF

PATRICK J. JOHNSTON

Surveyed MAY 23 1973, by T. PAUL