


T.4S. R.2W. W.M.

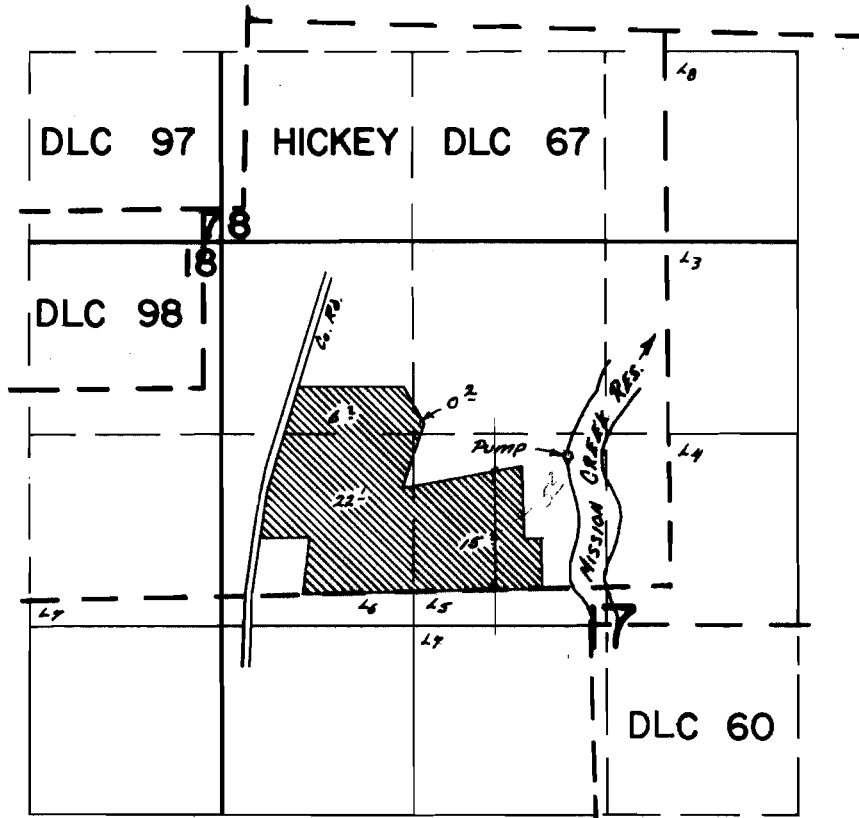

PUMP Loc: 890' N + 690' W FROM SE COR HICKEY DLC 67

FINAL PROOF SURVEY UNDER

Application No. 45259 Permit No. 39221
IN NAME OF

MRS. TRESSIE MULLEN

Surveyed May 24 1978, by T. J. PAULL