


**T.5S. R.1W. W.M.**

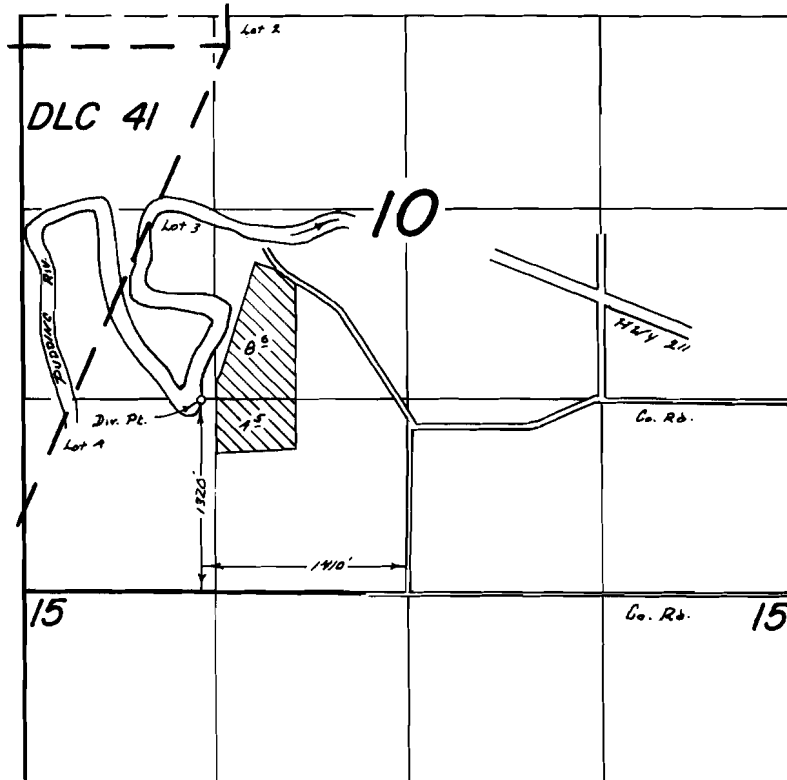

**FINAL PROOF SURVEY  
UNDER**

Application No. 45154 Permit No. 33738  
IN NAME OF

THOMAS E. WESTWOOD

Surveyed April 27 1973 by R. G. Mucken