


T. 4 S., R. 2 W. W.M.

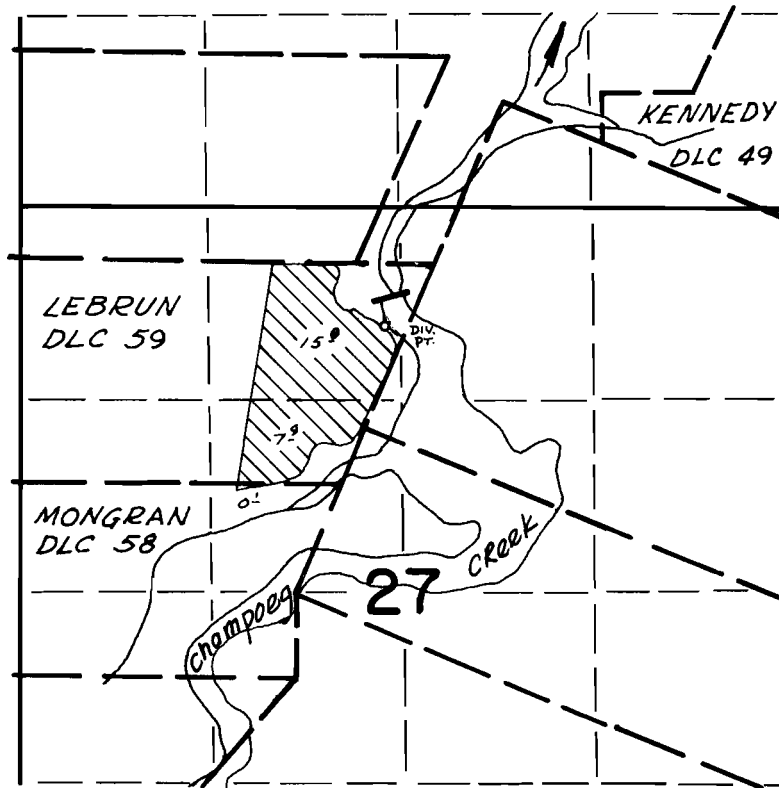

DIV. PT. LOCATED: 1620'S & 2130' W FROM W'LY INT. 'L'COR KENNEDY DLC 49

FINAL PROOF SURVEY UNDER

Application No. 45995 Permit No. 34354
IN NAME OF

RICHARD McKAY

Surveyed Oct. 2 1972, by D. Norby