


T.4S. R.2W. W.M.

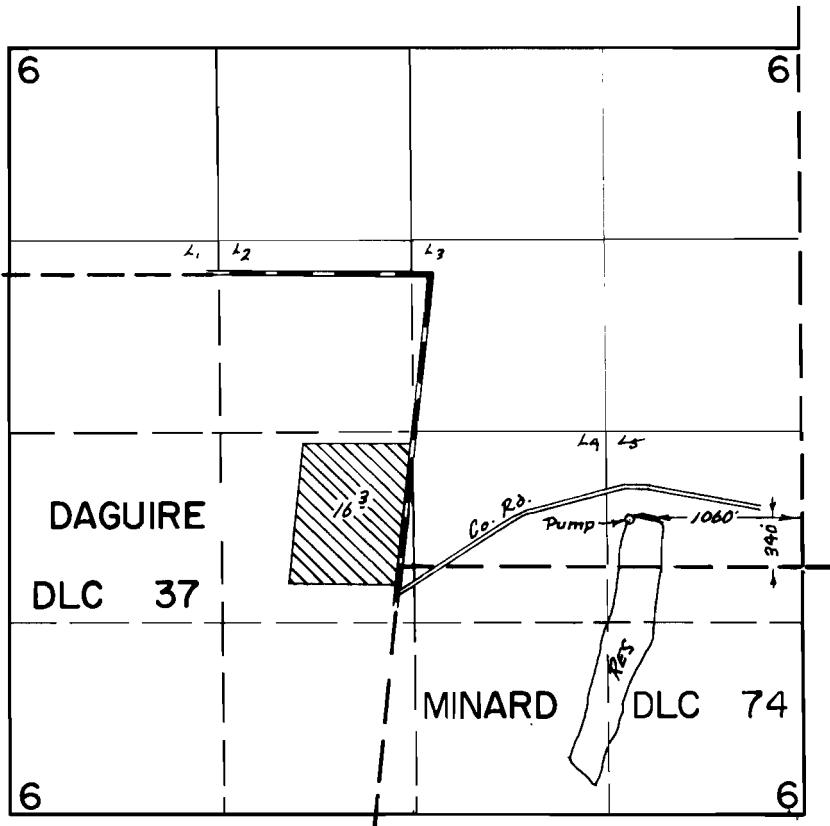

FINAL PROOF SURVEY
UNDER

Application No. 46041 Permit No. 34383
IN NAME OF

JACK FREDRICKSON

Surveyed JUNE 6 1973 by R.G. MUCKEN