
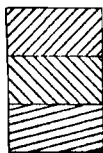


T.5S. R.1W. W.M.

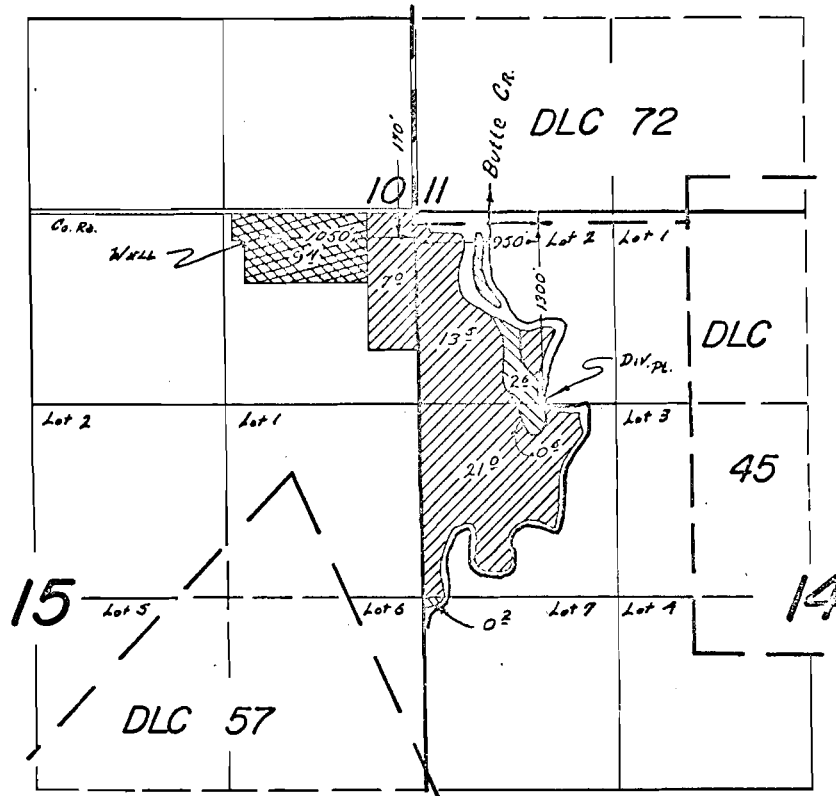

Supplemental Butte Cr. Per. 35542

Primary Butte Cr. Per. 35542

Supplemental Well Per. G-4936

FINAL PROOF SURVEY
UNDER

Application No. G-5330 47438 Permit No. G-4936 35542
IN NAME OF

ROBERT PFEIFER

Surveyed April 24 1973, by R. B. Mucken