


T.6S,R38E.,W.M.

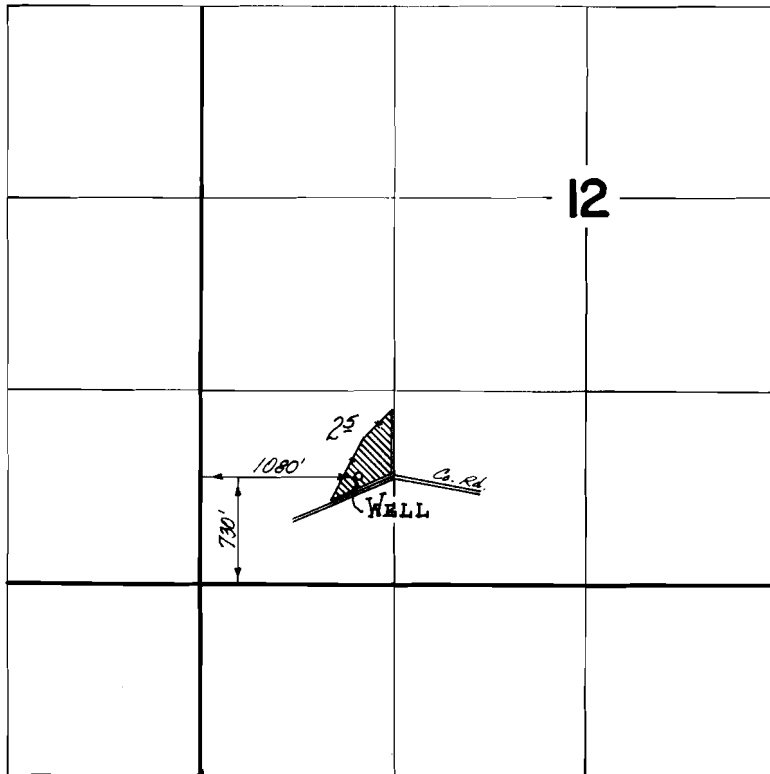

**FINAL PROOF SURVEY**  
UNDER

Application No. G-5053 Permit No. G-4763  
IN NAME OF

EMIL R. & WENDELL M. MILLER

Surveyed July 16, 1973, by D. NORBY