


T.2S. R.39E. W.M.

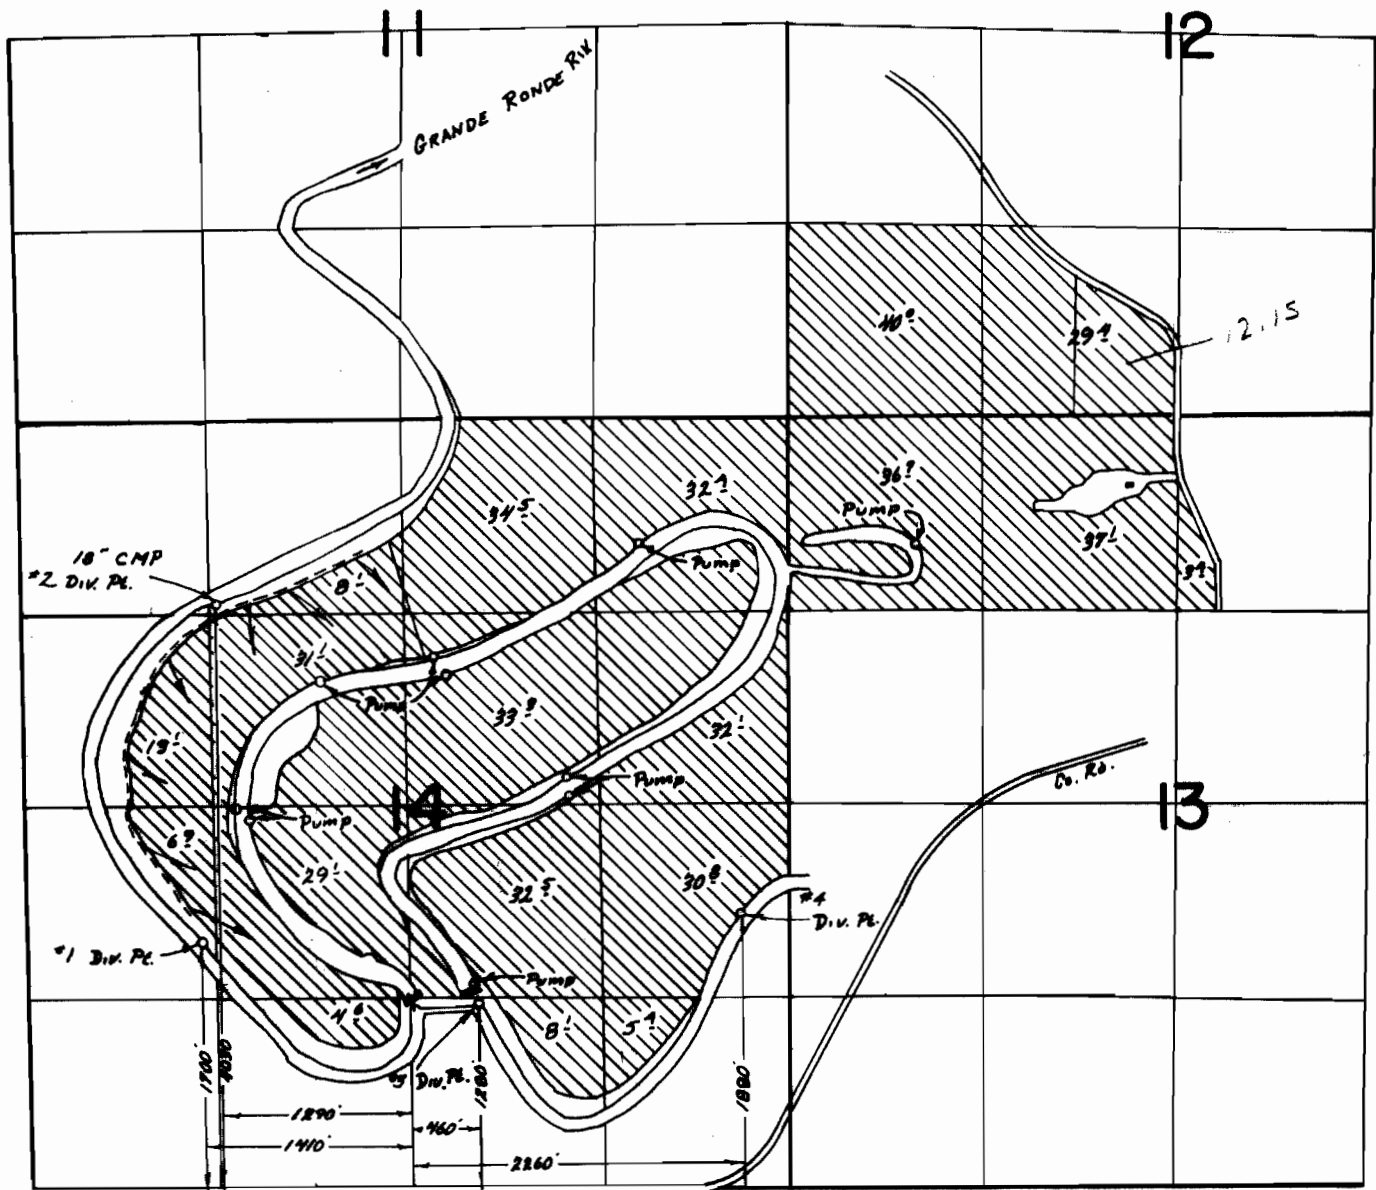

FINAL PROOF SURVEY
UNDER

DAM Loc: 1320' N 1° 20' W
FROM 3/4 Cor Sec 14

Application No. R-41214
41215 Permit No. R-4657
70816
IN NAME OF
DUANE FLEET

Surveyed July 17, 1979, by R.B. Mucken