


T.2S. R.39E. W.M.

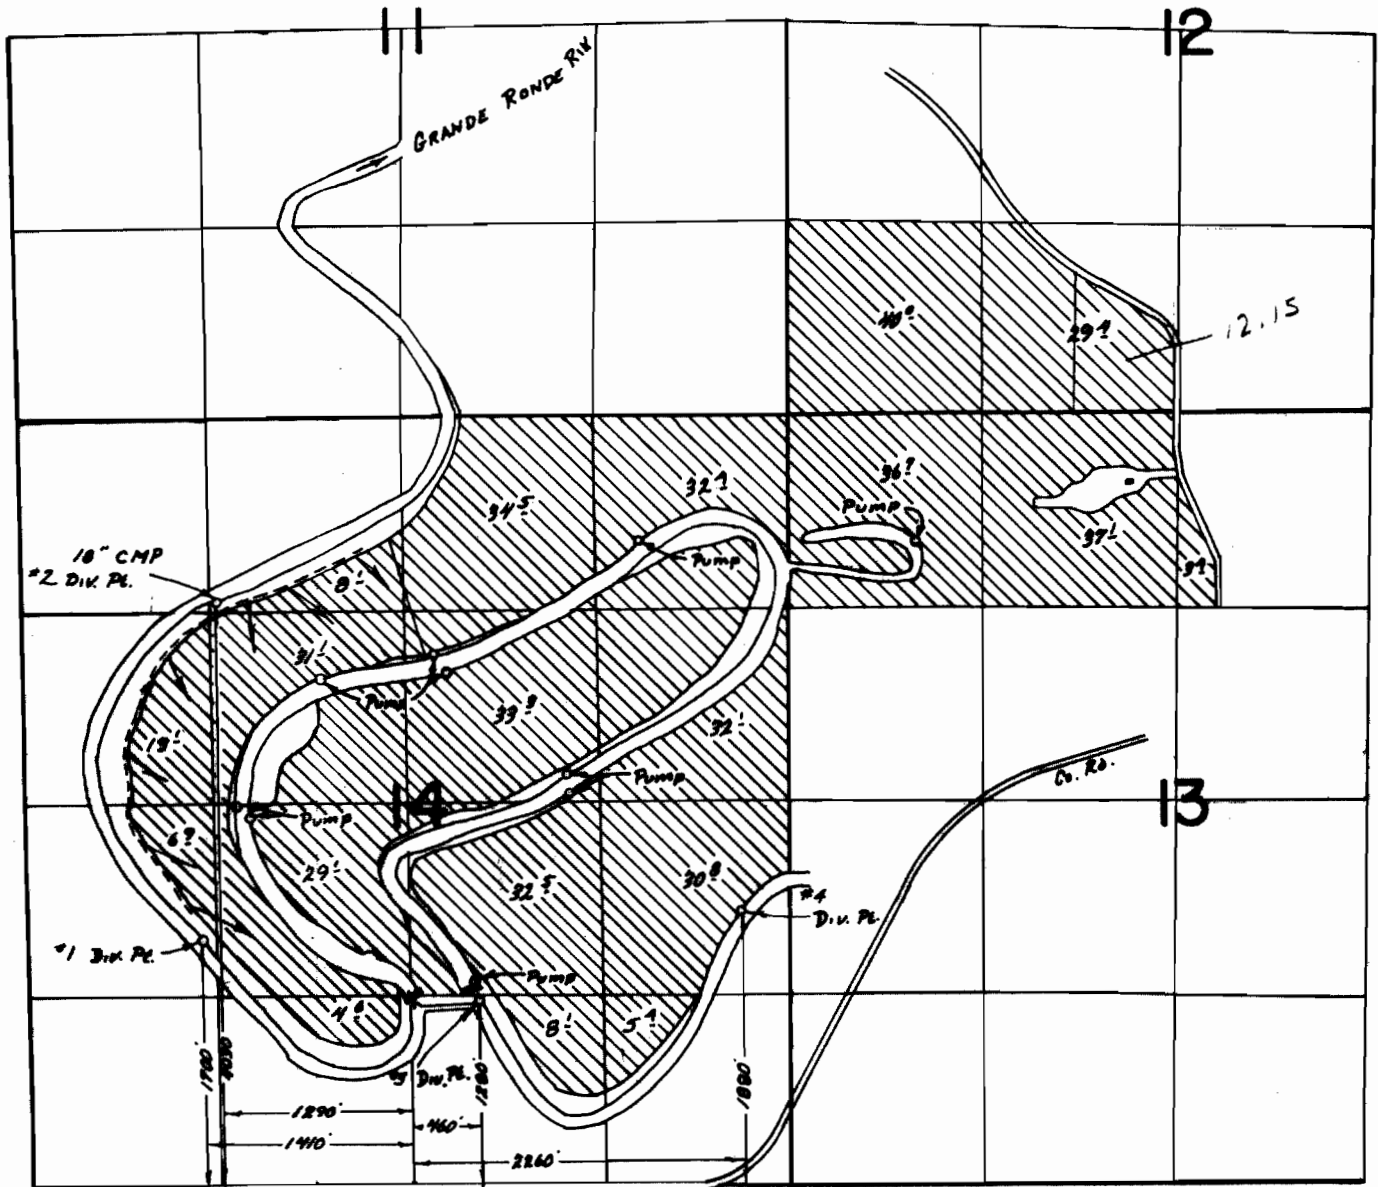

FINAL PROOF SURVEY
UNDER

DAM Loc: 1320' N 1 20' W
FROM 3/4 Cor Sec 14

Application No. R-41214 Permit No. R-4654
41215 20816
IN NAME OF
DUANE FLEET

Surveyed JULY 17 1973, by R.B. Mucken