


T.6S.,R.38E.,W.M.

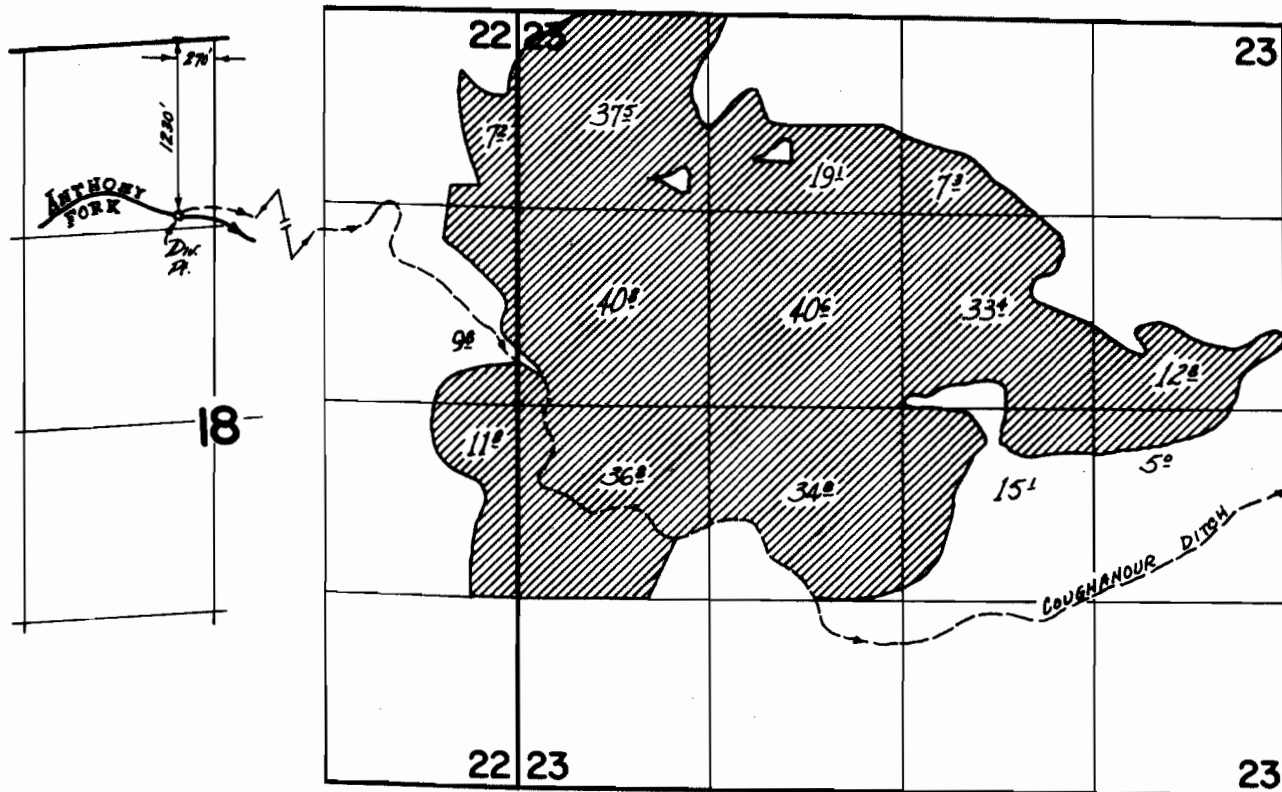

FINAL PROOF SURVEY
UNDER

Application No. 43066 Permit No. 32178
IN NAME OF

H. C. SCHWABROW

Surveyed July 16, 1973, by D. Naray