


T.2S.,R.38E.,W.M.

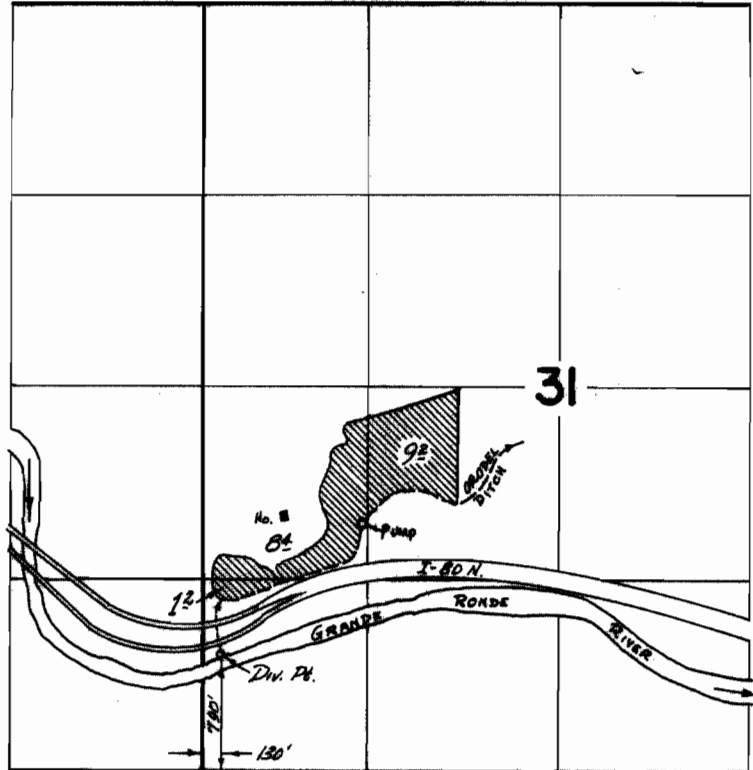

FINAL PROOF SURVEY
UNDER

Application No. 43723 Permit No. 32681
IN NAME OF

WALTER H. SWEET

Surveyed July 19 1973, by D. NERRY