


T.6S.R.41E.W.M.

RECEIVED
SEP 22 1970
STATE ENGINEER
SALEM OREGON

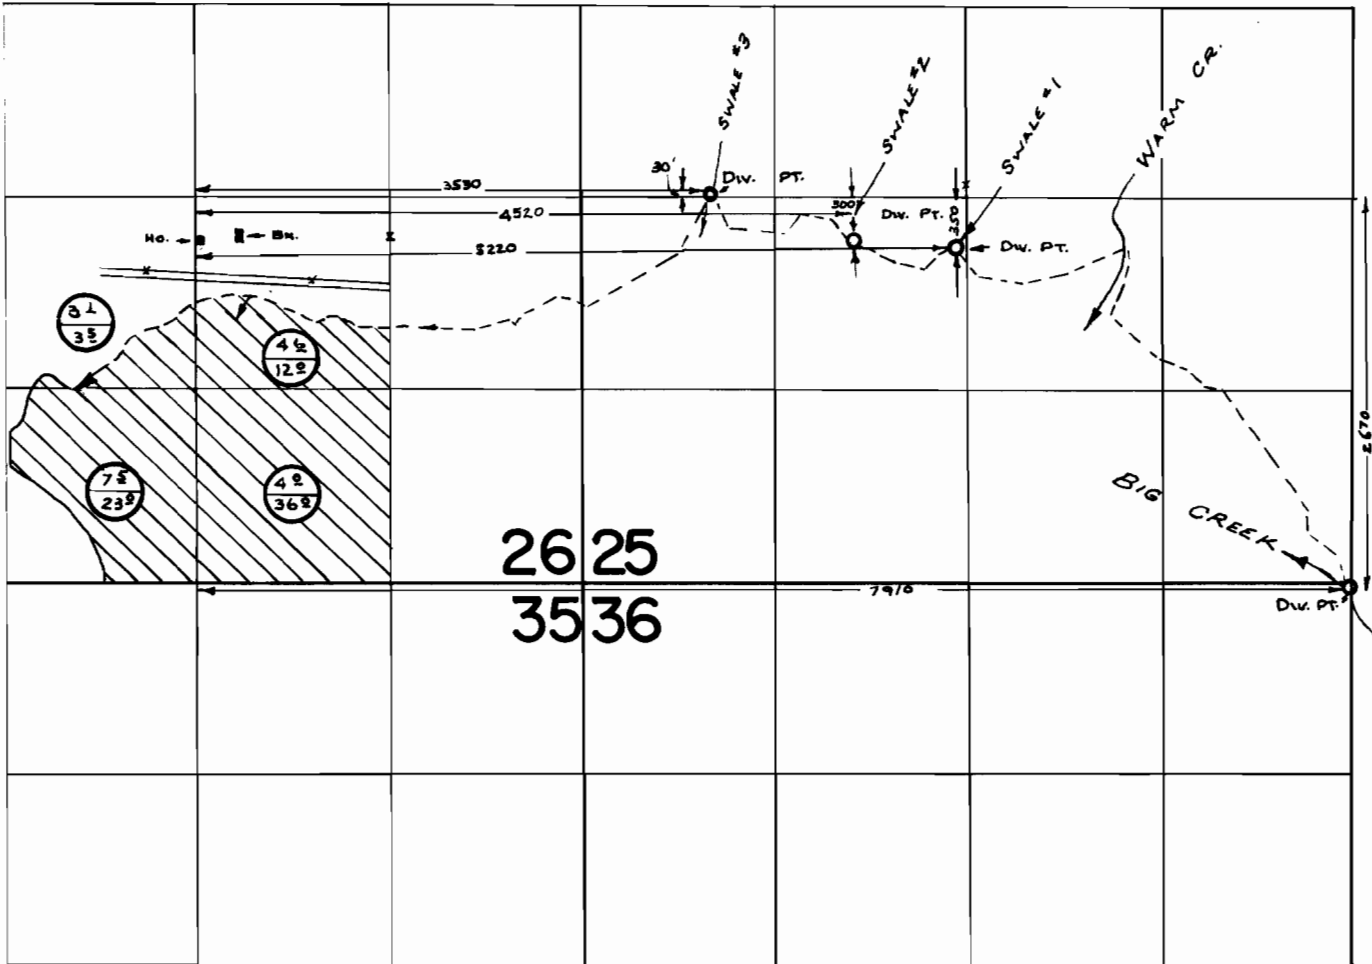

26 25
35 36

47556
35601

WATER RIGHT MAP
FOR

Application No. _____ Permit No. _____
IN NAME OF

OSCAR J. WANKER

Surveyed MAY 12, 1970, by L. E. GOULD