


T.2S. R.45E. W.M.

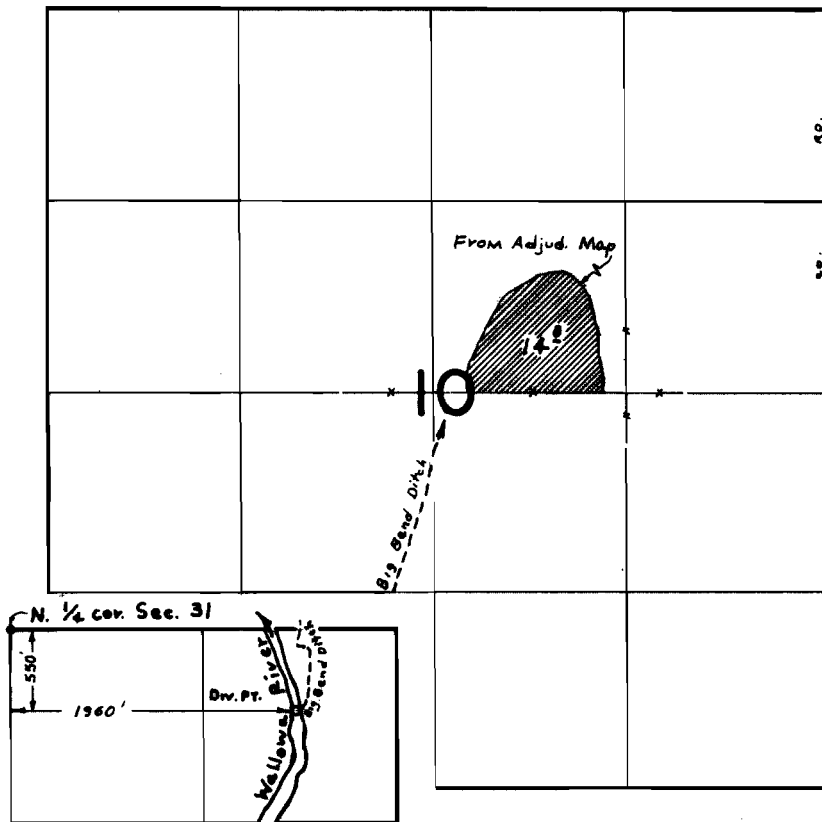

FINAL PROOF SURVEY
UNDER

Application No. 40669 Permit No. 30524
IN NAME OF

Wayne McFetridge, et al.

Surveyed AUG. 1, 1973, by R. MUCKEN