


T.2N.R.3W.W.M.

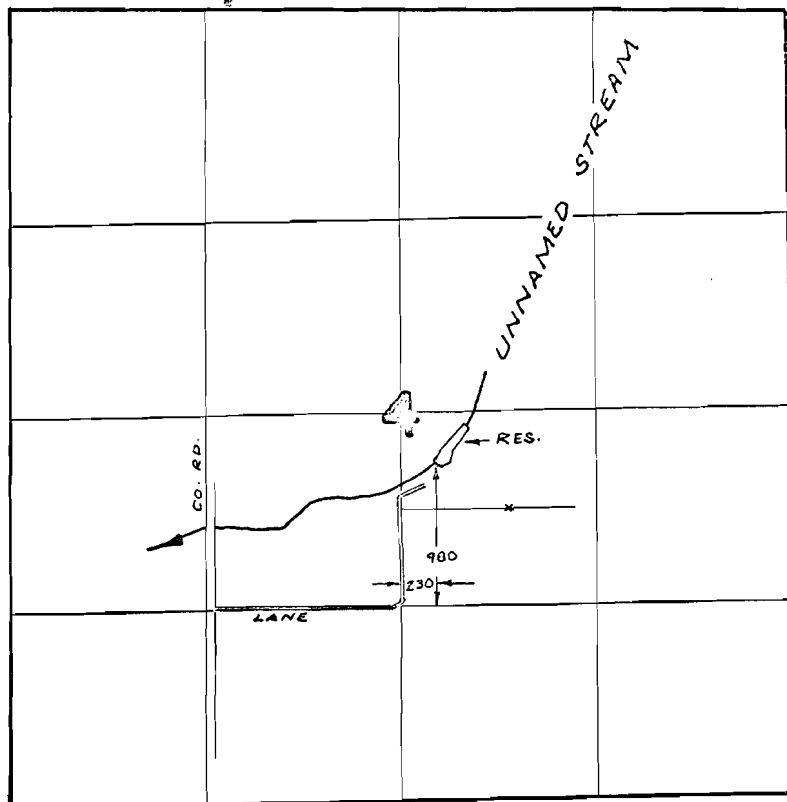

FINAL PROOF SURVEY
UNDER

Application No. R-40130 40359 Permit No. R-4469 29963
IN NAME OF

EDNA R. BELLER

Surveyed SEPT. 25, 1972, by R. MUCKEN