


T.2N.R.2W.W.M.

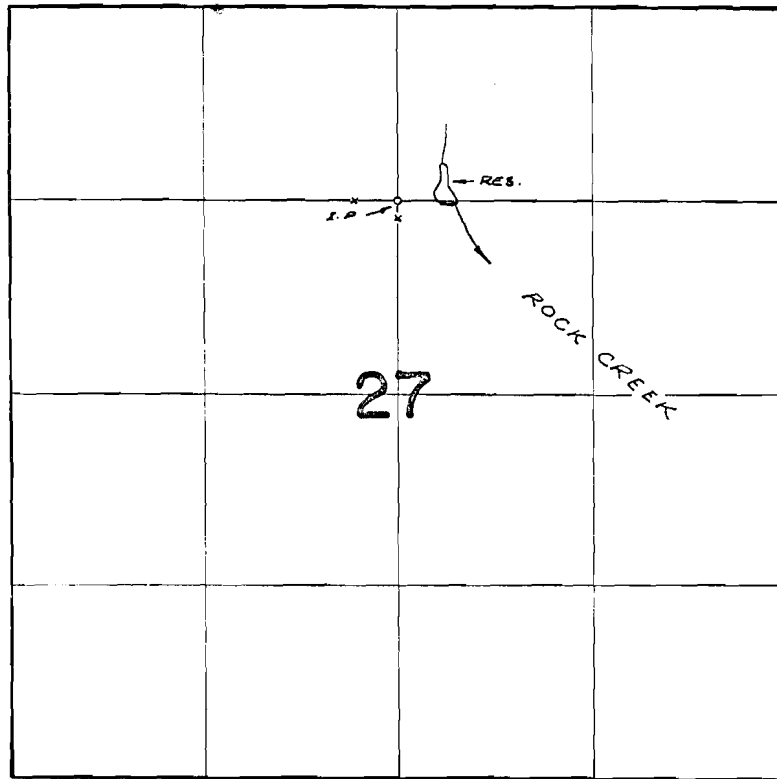

DIV. PT. LOC: 20'S. & 490'E. FROM N.W. COR. SW $\frac{1}{4}$ NE $\frac{1}{4}$ SEC. 27

FINAL PROOF SURVEY
UNDER

Application No. ^{R-41518} 41761 Permit No. ^{R-4675} 31038
IN NAME OF

..... DAVID TROUTMAN

Surveyed SEPT. 19, 1972, by R. MUGGEN