


T.2N.R.3W.W.M.

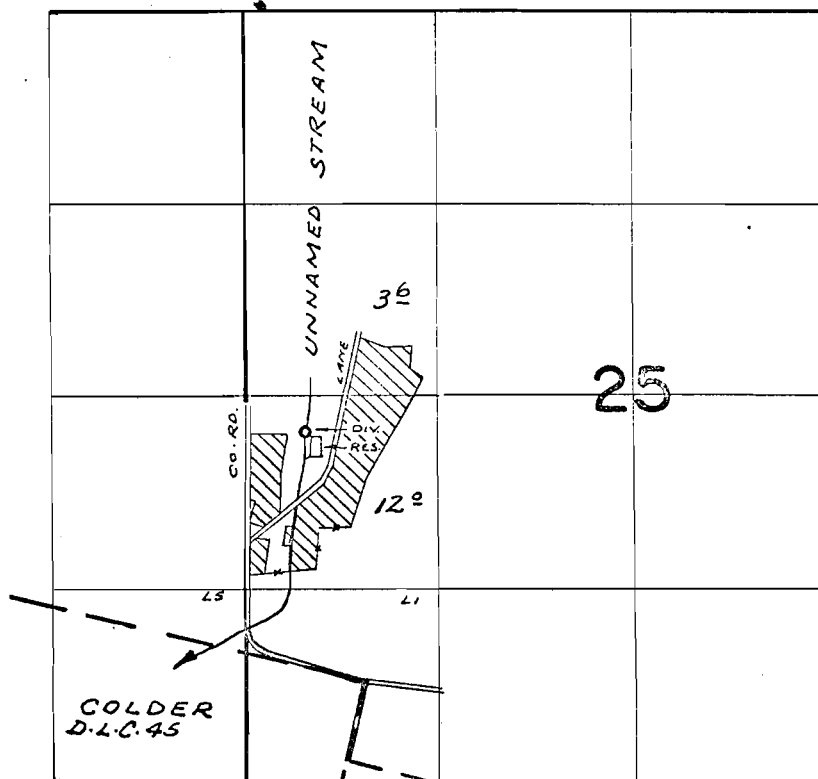

DIV. PT. LOC: 1710'N. & 400'W. FROM N.E. COR. COLDER D.L.C. 45
SUMP LOC: 1600'N. & 320'W. FROM N.E. COR. COLDER D.L.C. 45

FINAL PROOF SURVEY
UNDER

R-42046 R-4783
Application No. 42047 Permit No. 31473
IN NAME OF

MAURICE KEMPER

Surveyed SEPT. 26, 1972, by R. MUCKEN