


# T. 15. R. 2W. W. M.

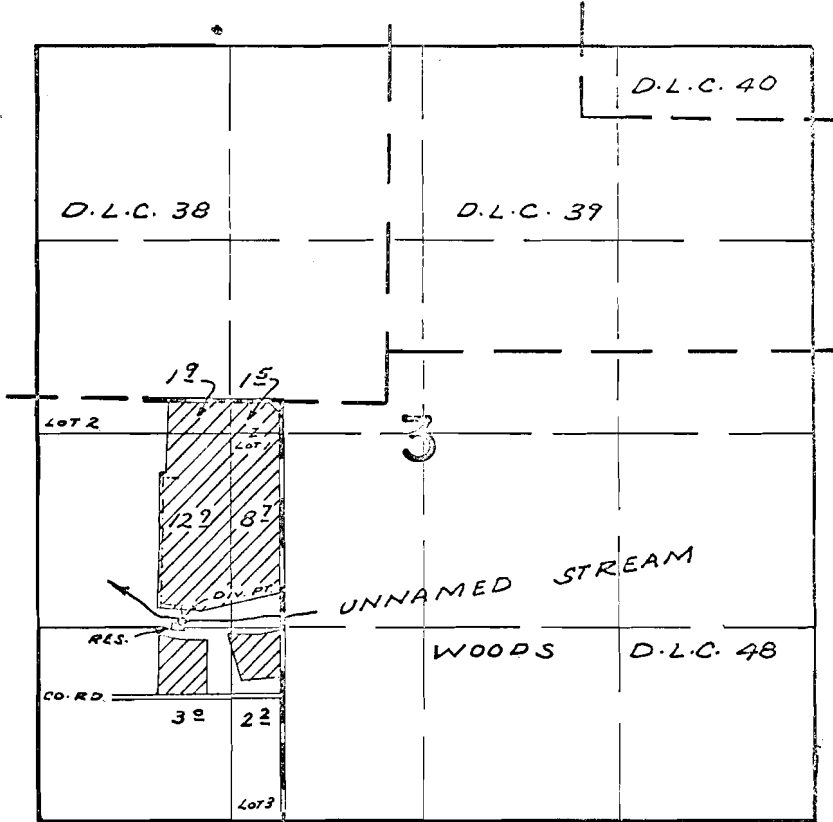

DIV. PT. LOC: 1510'S. & 670'W. FROM MOST WSTLY. N.W. COR.  
 WOODS D.L.C. 48  
 RES. LOC: 1540'S. & 700'W. FROM MOST WSTLY N.W. COR.  
 WOODS D.L.C. 48

## FINAL PROOF SURVEY UNDER

R-43509                      R-4876  
 Application No. 42262 Permit No. 31963  
 IN NAME OF

WILLIAM WALLACE

Surveyed OCT 31, 1972, by R. MUCKEN