


T.I.S.R.I.W.W.M.

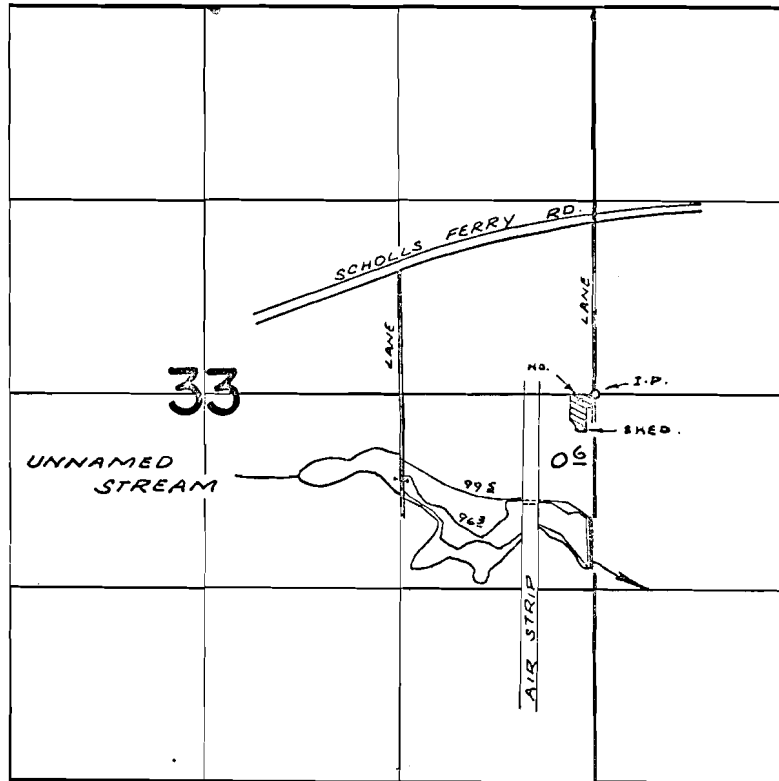

DIV. PT. LOC: 1140'S. & 20' W. FROM E. 1/4 COR. SEC. 33

FINAL PROOF SURVEY UNDER

R-43554 R-5070
Application No. 43555 Permit No. 32879
IN NAME OF

HERBERT A. & RUTH J. STARK

Surveyed Nov. 2, 1972, by R. MURKEN