


T.I.S.R.I.W.W.M.

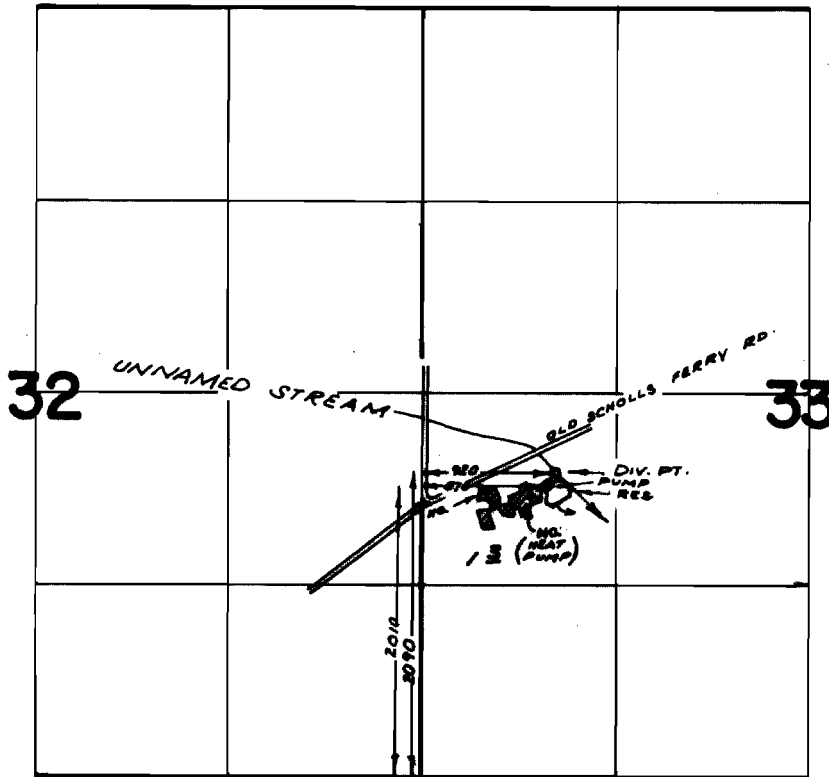

FINAL PROOF SURVEY UNDER

R-44336 R-5100
Application No. 44085 Permit No. 32995
IN NAME OF

G. V. PALMROSE

Surveyed Nov. 2, 1972 by R. MUCKEN