


# T.I.S.R.I.W.W.M.

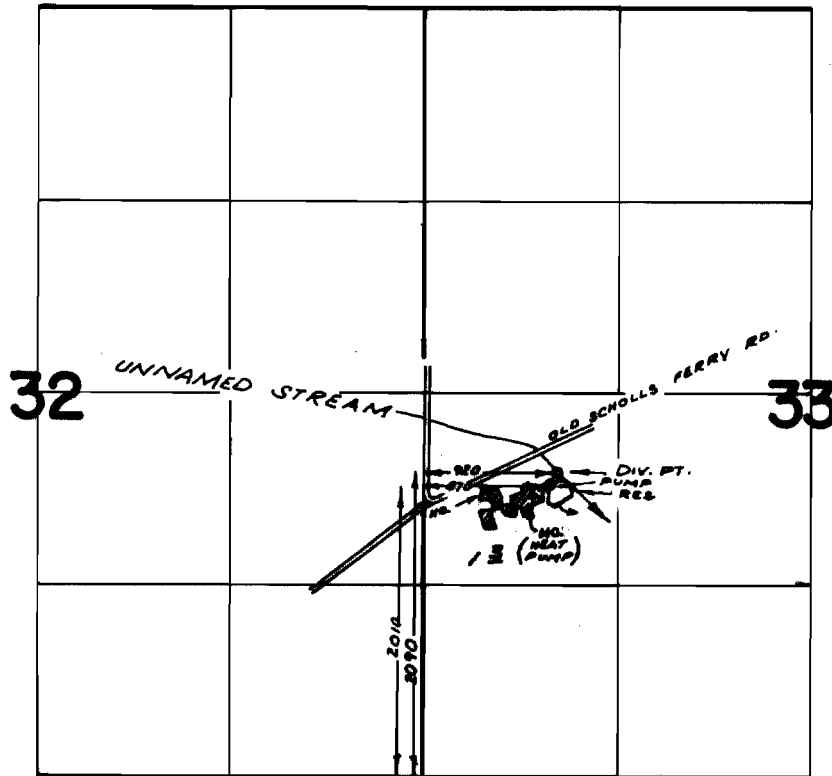

## FINAL PROOF SURVEY UNDER

R-44336 R-5100  
Application No. 44085 Permit No. 32995  
IN NAME OF

G. V. PALMROSE

Surveyed MAY 2, 1972 by B. MUCKEN