


T.I.S.R.I.W.W.M.

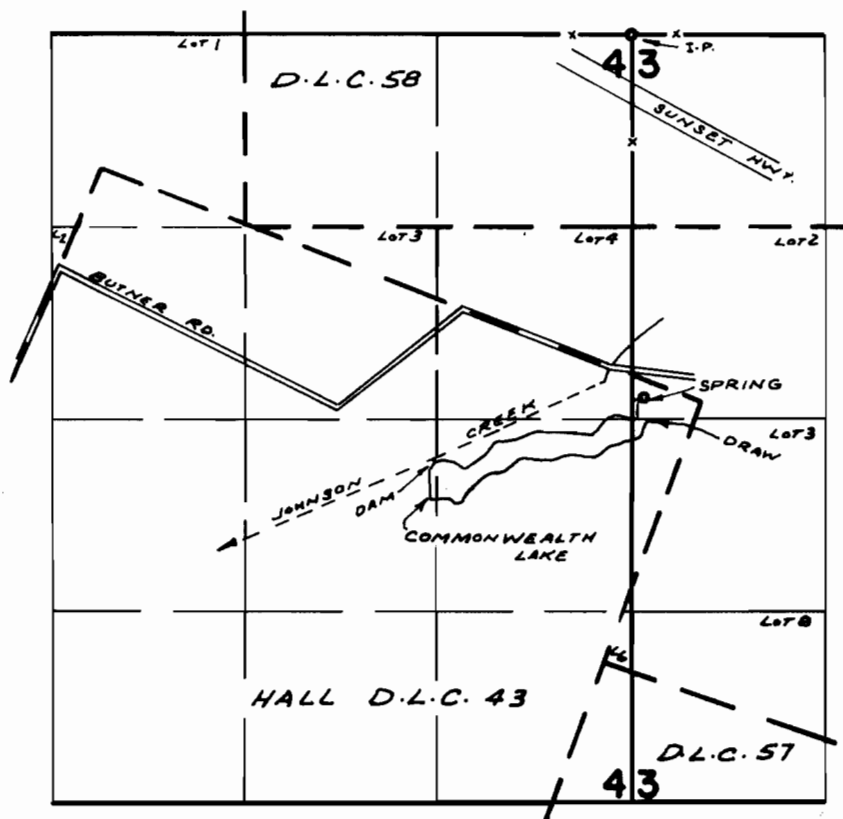

DIV. PT. LOC: 2940'S. & 1360'W. FROM N.E. COR. SEC. 4

FINAL PROOF SURVEY UNDER

R-46488 R-5478
Application No. 46489 Permit No. 34404
IN NAME OF

TUALATIN HILLS PARK & RECREATION DISTRICT

Surveyed OCT. 31, 1972, by R. MUCKEN