T.1S.R.1W.W.M.

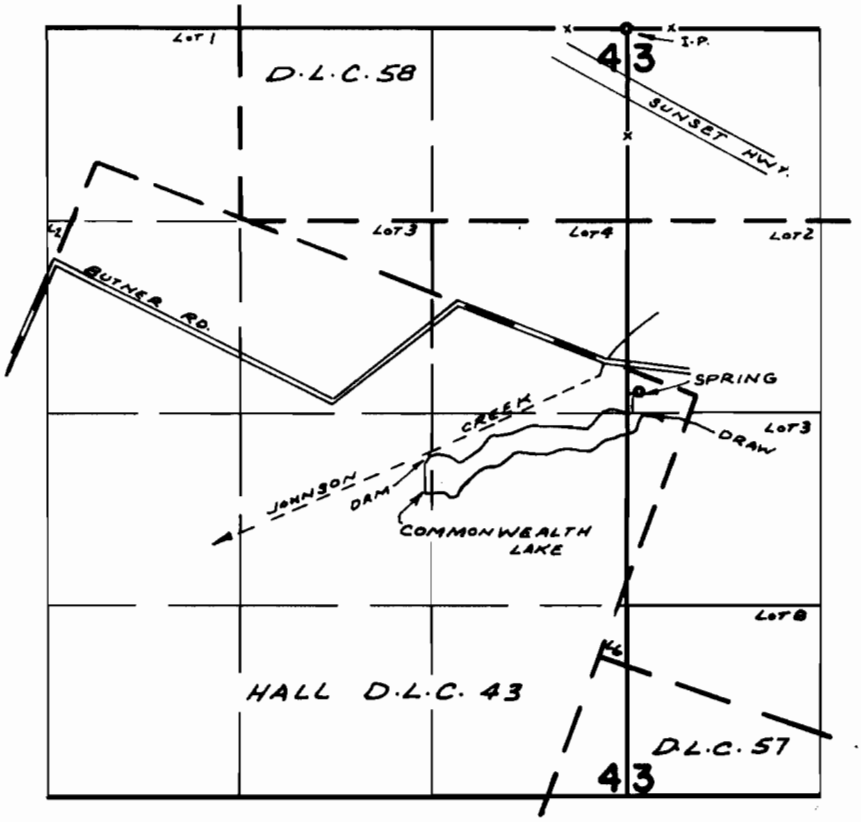

DIV. PT. LOC.: 2940'S. & 1360'W. FROM N.E. COR. SEC. 4

FINAL PROOF SURVEY
UNDER

Application No. R-46488 46489 Permit No. R-5478 34404
IN NAME OF

TUALATIN HILLS PARK & RECREATION DISTRICT

Surveyed OCT. 31, 1972, by R. MUCKEN

1972-0