


T.2N.R.3W.W.M.

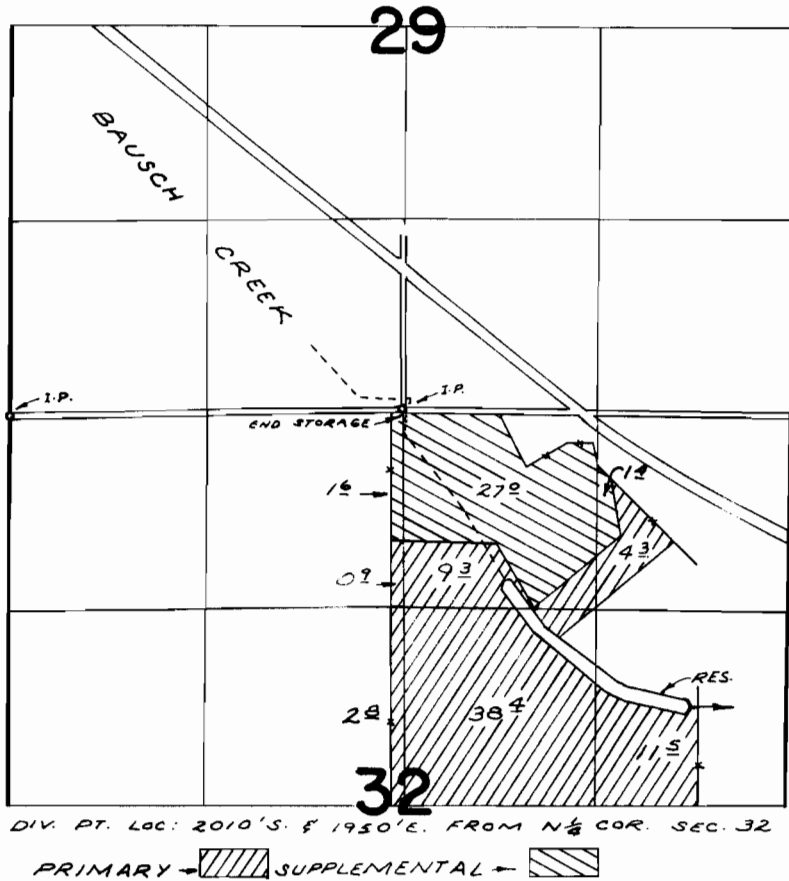

FINAL PROOF SURVEY UNDER

R-47474 R-5600
 Application No. 47475 Permit No. 34952
 IN NAME OF

WILLIAM RUFENER

Surveyed SEPT. 28, 1972, by R. MUCKEN