


T.2N.,R.5W.,W.M.

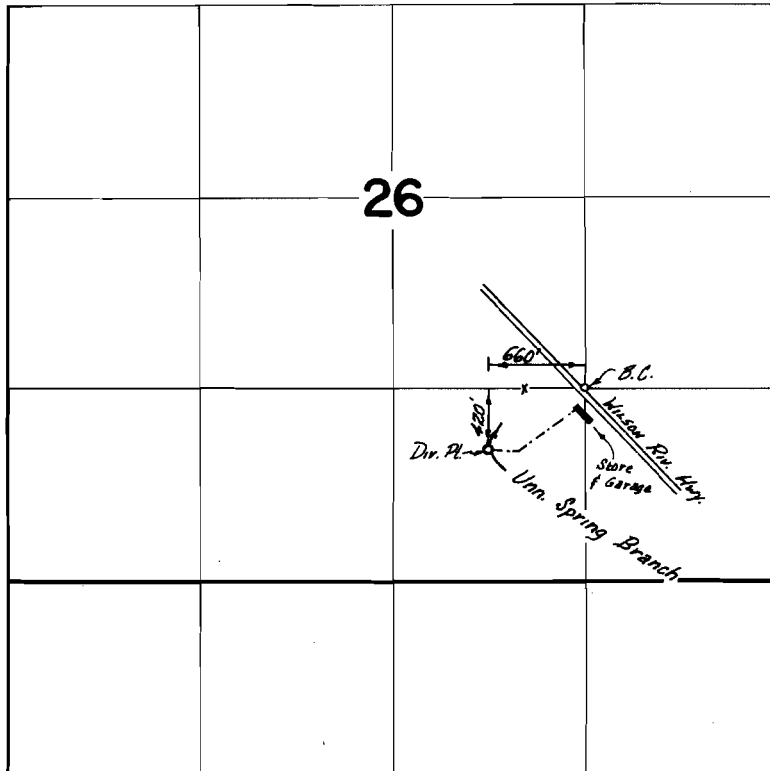

FINAL PROOF SURVEY
UNDER

Application No. 40392 Permit No. 30110
IN NAME OF

CHARLES R. BATEMAN

Surveyed JUNE 29 1973, by D. NORBY