


T.1S.R.2W.W.M.

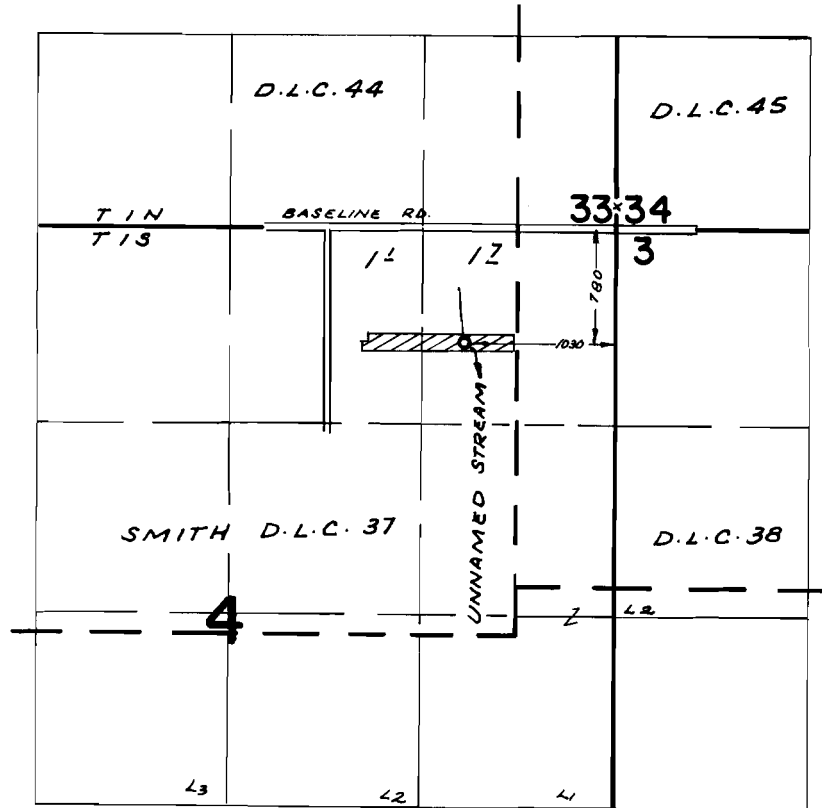

FINAL PROOF SURVEY UNDER

Application No. 45026 Permit No. 33406
IN NAME OF

PATRICIA N. & KENNETH M. WAY

Surveyed OCT. 30, 1972, by R. MUCKEN