


T. 1N., R. 4W., W.M.

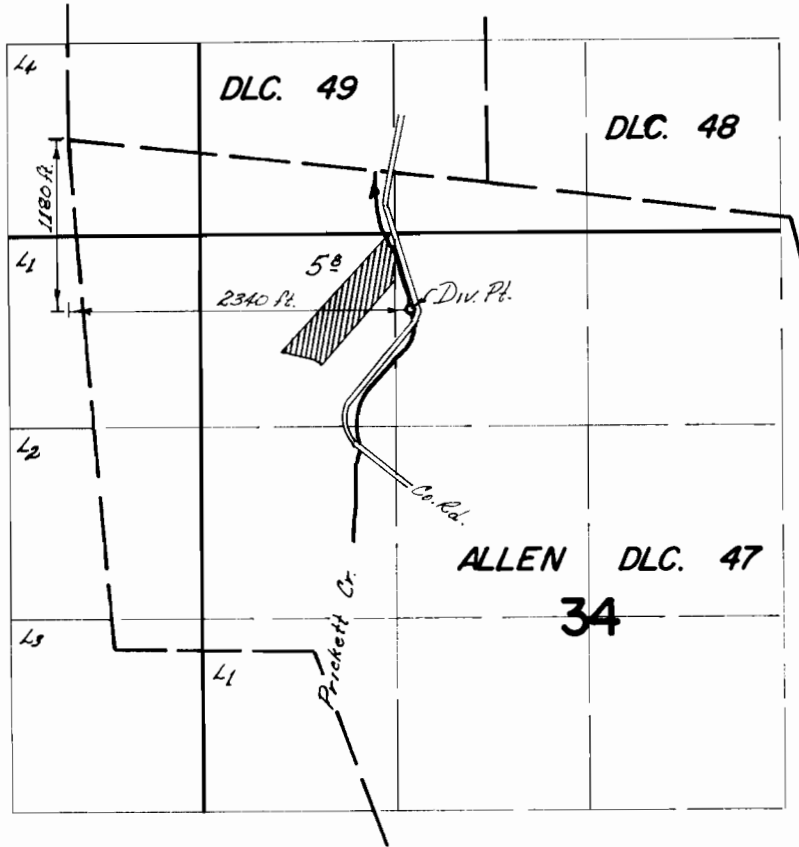

FINAL PROOF SURVEY
UNDER

Application No. 44719 Permit No. 33503
IN NAME OF

THORALD D. BAGLEY

Surveyed June 25 1973, by D. NORBY