


T. 1N, R. 4W., W.M.

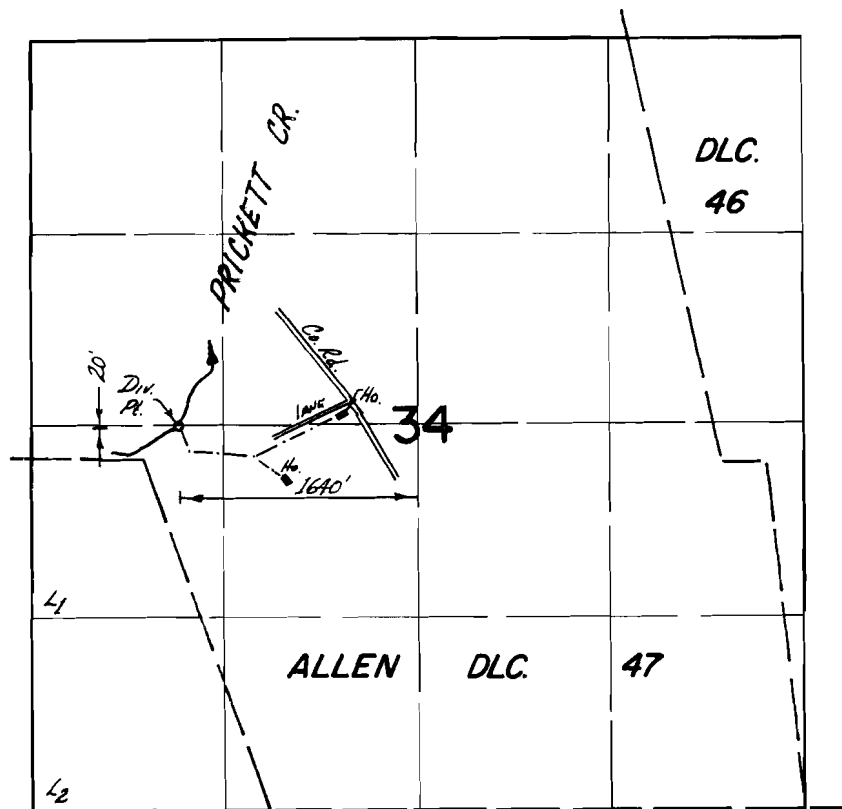

FINAL PROOF SURVEY
UNDER

Application No. 45143 Permit No. 33726
IN NAME OF

ROLLAND W. FUNK & MARSHALL V. WALKER

Surveyed JUNE 25 19 73, by D. NOREY