


T.I.S.R.I.W.W.M.

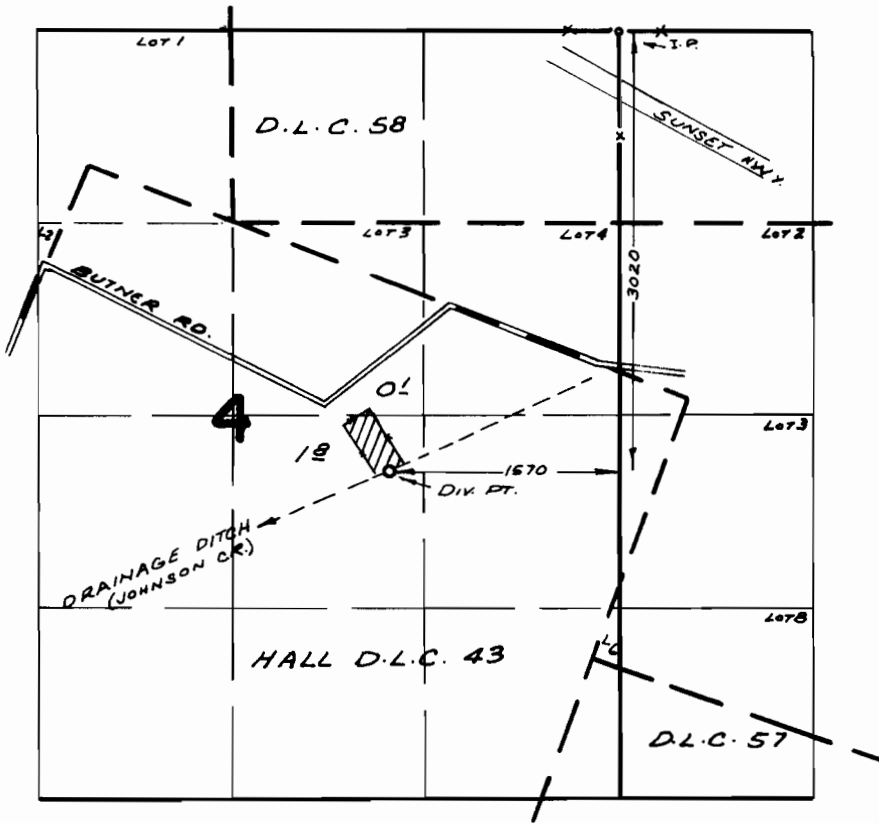

FINAL PROOF SURVEY UNDER

Application No. 46665 Permit No. 34865
IN NAME OF

JOE VINCENT CARUSO

Surveyed OCT. 31, 1972, by R. MCKEN