


T.2N.,R.5W.,W.M.

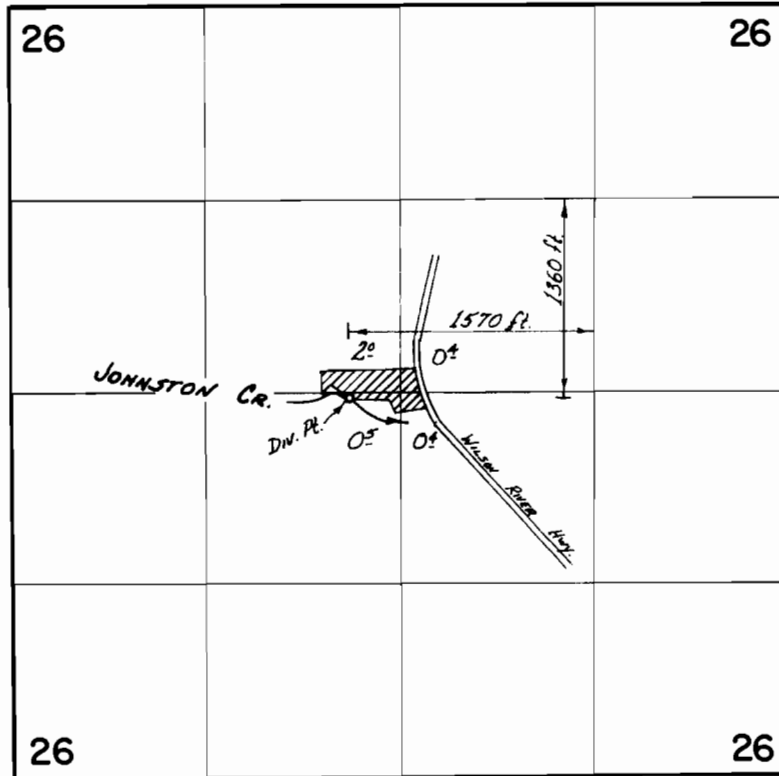

**FINAL PROOF SURVEY**  
UNDER

Application No. 47902 Permit No. 35894  
IN NAME OF

HENRY SCHROEDER

Surveyed JUNE 29 1913, by D. NORBY