# T. 1N., R. 4W., W.M.

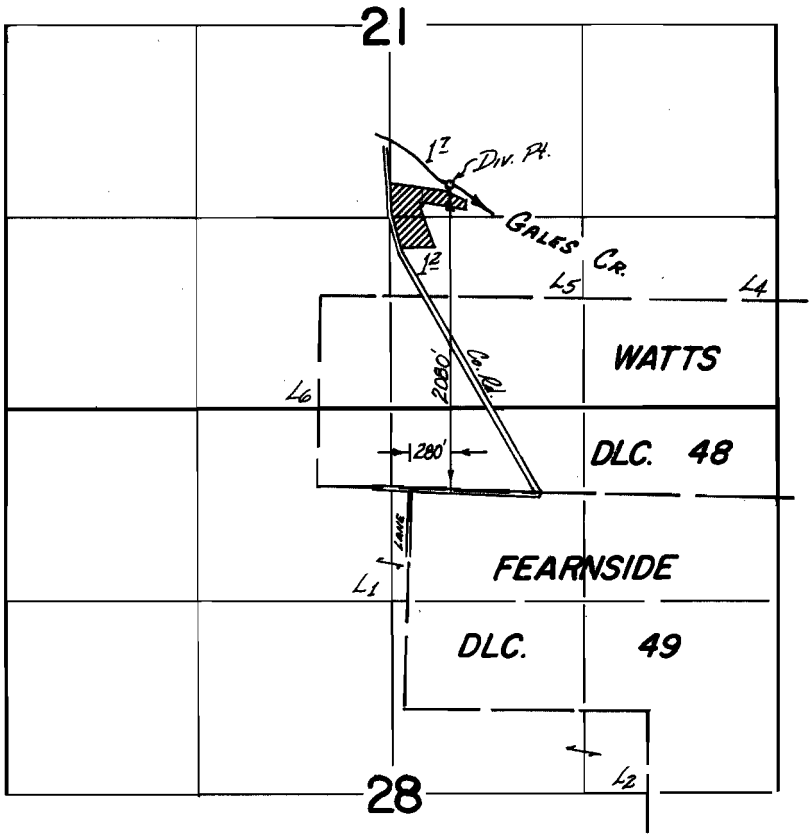


## FINAL PROOF SURVEY
UNDER

Application No. 48469 Permit No. 36377
IN NAME OF

JOHN FRANCIS COTA

Surveyed June 26 1973, by D. Norby

1973-A