


T.48&5S. R.3W. W.M.

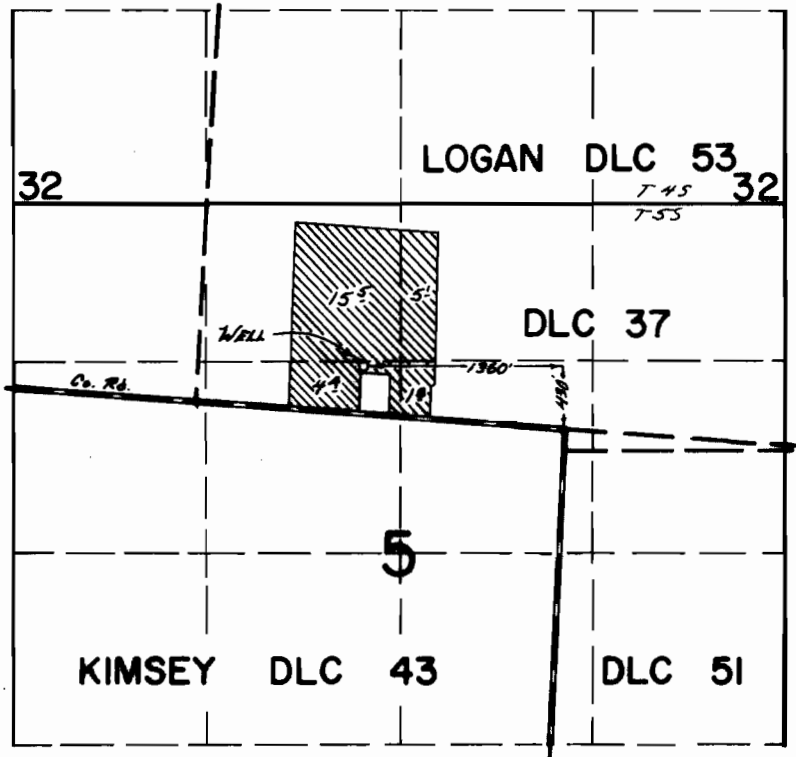

FINAL PROOF SURVEY
UNDER

Application No. G-4389 Permit No. B-4140
IN NAME OF

JOHN CONNER

Surveyed SEPT. 7 1977, by L. E. GOULD